


CORNER RECORD

Document Number CR-12-14

City of STOCKTON

County of SAN JOAQUIN, California

Brief Legal Description ROCKWOOD CIRCLE AND ROCKWOOD COURT, M.&P. 35-10, SEC. 30,
T.2N., R.6E., M.D.B.&M.

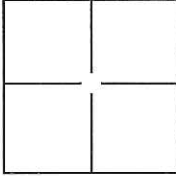

CORNER TYPE

Government Corner ☐ Control ☐
Meander ☐ Property ☐
Rancho ☐ Other ☒

Date of Survey DECEMBER 06, 2011

COORDINATES(Optional)

N. _____
E. _____
Zone _____ NAD27 ☐ NAD83 ☐
NAD83 Epoch _____
Elev. _____
Vert. Datum: NGVD29 ☐ NADV88 ☐
Meas. Units: Metric ☐ Imperial ☐

Corner - Left as found ☐ Found and tagged ☐ Established ☐ Reestablished ☒ Rebuilt ☐

Identification and type of corner found: Evidence used to identify or procedure used to establish or reestablish the corner:

SEE PLAT ON BACK

A description of the physical condition of the monument as found and as set or reset: _____

SET 3/4", 30" LONG REBAR WITH CAP ATTACHED AND STAMPED "LS 8247" IN MONUMENT WELL.

SURVEYOR'S STATEMENT

This Corner Record was prepared by me or under my direction in conformance with

the Land Surveyor's Act on DECEMBER 19, 2011.

Signed [Signature] P.L.S. or R.C.E. No.: 8247



COUNTY SURVEYOR'S STATEMENT


This Corner Record was received January 9, 2012 and examined

and filed February 8, 2012.

Signed Thomas M. Gau P.L.S. or R.C.E. No.: 26994


Title County Surveyor

County Surveyor's Comment _____

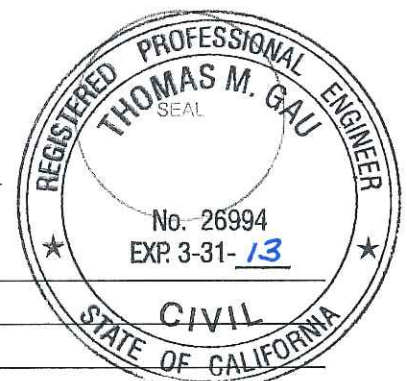


LEGEND:

- M.&P. BOOK OF MAPS AND PLATS, VOLUME-PAGE
- + FOUND CHISELED CROSS PER M.&P. 35-10
- ⊙ SET ¾" REBAR, 30" LONG W/CAP ATTACHED AND STAMPED "LS 8247" IN MONUMENT WELL
- FOUND PK NAIL W/TAG STAMPED "PLS 8092" PER CORNER RECORD CR 11-174

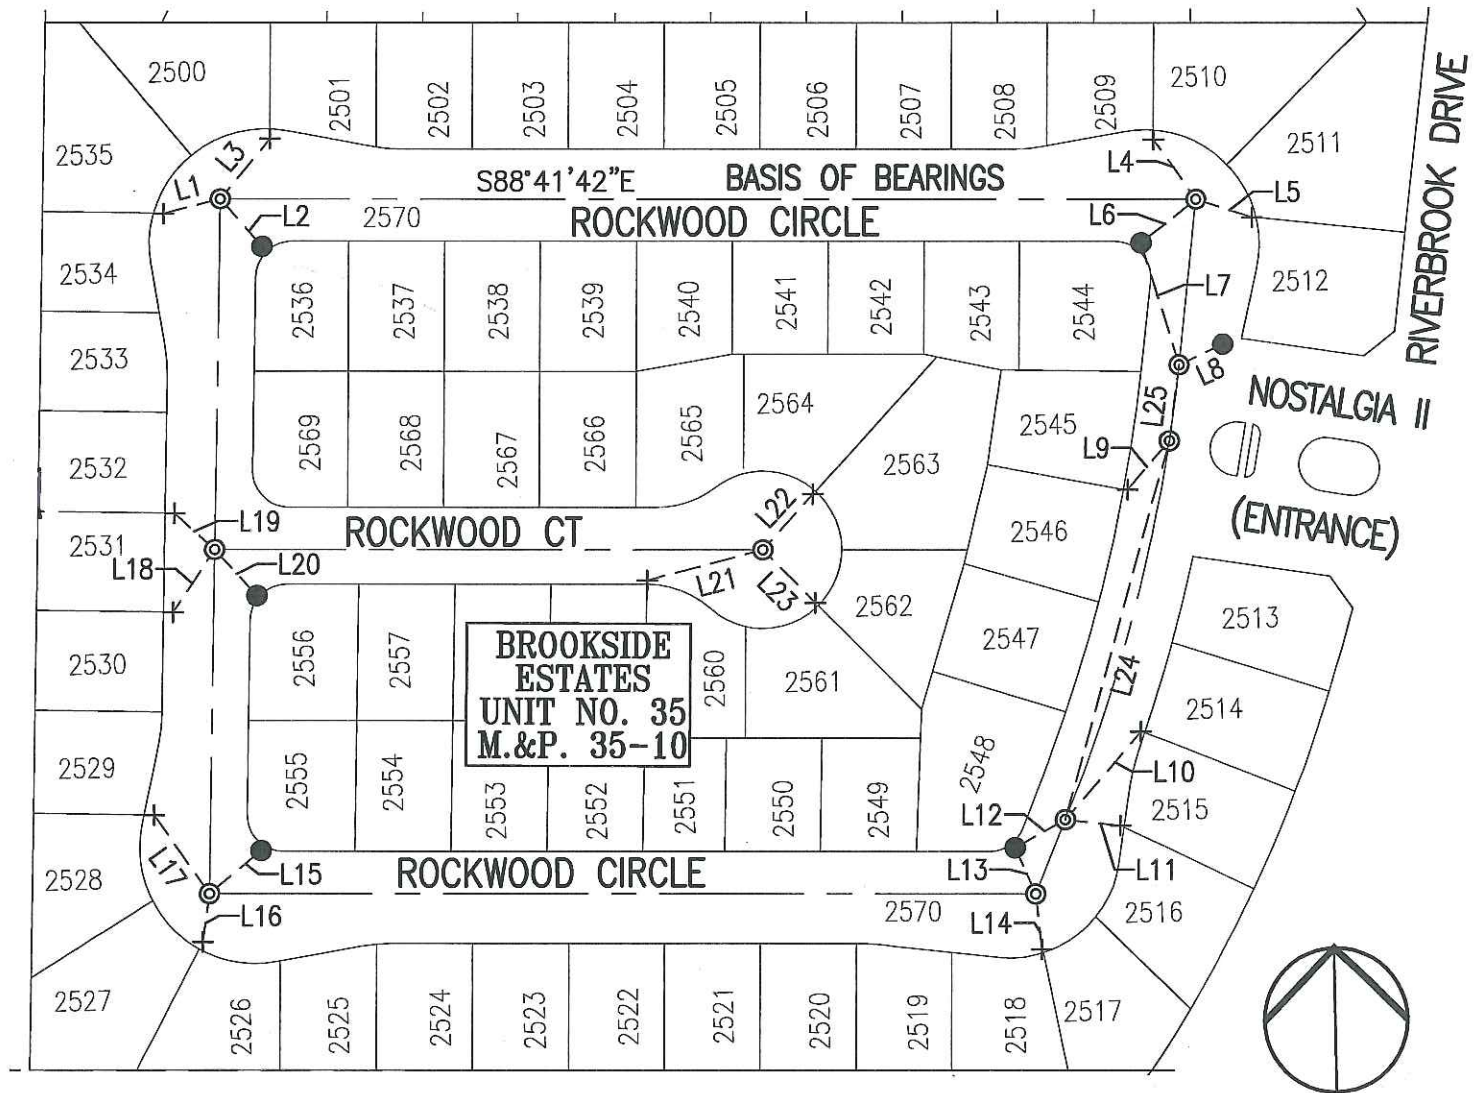

BASIS OF BEARINGS:

THE CENTERLINE OF ROCKWOOD CIRCLE WHICH BEARS S88°41'42"E PER M.&P. 35-10

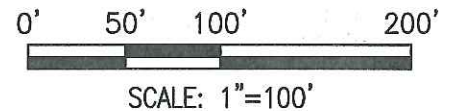

LINE TABLE		
LINE #	DIRECTION	LENGTH
L1	S76°47'24"W	30.42'
L2	N39°56'34"W	33.08'
L3	S40°31'13"W	40.53'
L4	S34°12'08"E	38.19'
L5	S70°53'59"E	31.14'
L6	N52°25'12"E	36.46'
L7	N15°54'25"W	66.68'

LINE TABLE		
LINE #	DIRECTION	LENGTH
L8	S66°16'36"W	25.51'
L9	N41°11'57"E	33.16'
L10	S41°39'20"W	59.94'
L11	S82°17'33"E	28.46'
L12	N62°07'37"E	30.02'
L13	S22°54'43"E	26.36'
L14	S5°20'04"E	29.05'

LINE TABLE		
LINE #	DIRECTION	LENGTH
L15	S51°20'32"W	34.93'
L16	N8°50'02"E	25.31'
L17	N33°51'29"W	50.04'
L18	N34°28'03"E	39.06'
L19	N46°31'27"W	27.97'
L20	N41°07'03"W	32.48'
L21	N76°33'36"E	62.48'

LINE TABLE		
LINE #	DIRECTION	LENGTH
L22	N43°12'48"E	38.91'
L23	N43°34'23"W	38.88'
L24	S16°18'11"W	204.01'
L25	N8°21'46"E	39.97'