


CORNER RECORD

Document Number CR-12-20

City of STOCKTON

County of SAN JOAQUIN, California

Brief Legal Description ST. ANDREWS DRIVE, M.&P. 35-72, SEC. 36, T.2N., R.5E., M.D.B.&M.

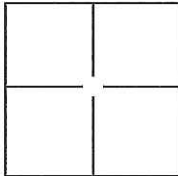

CORNER TYPE

Government Corner ☐ Control ☐
Meander ☐ Property ☐
Rancho ☐ Other ☒

Date of Survey DECEMBER 12, 2011

COORDINATES(Optional)

N. _____
E. _____
Zone _____ NAD27 ☐ NAD83 ☐
NAD83 Epoch _____
Elev. _____
Vert. Datum: NGVD29 ☐ NADV88 ☐
Meas. Units: Metric ☐ Imperial ☐

Corner - Left as found ☐ Found and tagged ☐ Established ☐ Reestablished ☒ Rebuilt ☐

Identification and type of corner found: Evidence used to identify or procedure used to establish or reestablish the corner:

SEE PLAT ON BACK

A description of the physical condition of the monument as found and as set or reset: _____

SET 3/4", 30" LONG REBAR WITH CAP ATTACHED AND STAMPED "LS 8247" IN MONUMENT WELL.

SURVEYOR'S STATEMENT

This Corner Record was prepared by me or under my direction in conformance with

the Land Surveyor's Act on DECEMBER 19, 2011.

Signed [Signature] P.L.S. or R.C.E. No.: 8247



COUNTY SURVEYOR'S STATEMENT

This Corner Record was received January 9, 2012 and examined

and filed February 5, 2012

Signed Thomas M. Gau P.L.S. or R.C.E. No.: 26994

Title County Surveyor

County Surveyor's Comment _____



LEGEND:


M.&P. BOOK OF MAPS AND PLATS, VOLUME-PAGE

+ FOUND CHISELED CROSS ON 2' OFFSET PER M.&P. 35-72 AND C.R. 11-108

⊙ SET ¾" REBAR, 30" LONG W/CAP ATTACHED AND STAMPED "LS 8247" IN MONUMENT WELL

BASIS OF BEARINGS:

THE CENTERLINE OF ST. ANDREWS DRIVE WHICH BEARS S10°18'28"W PER M.&P. 35-72

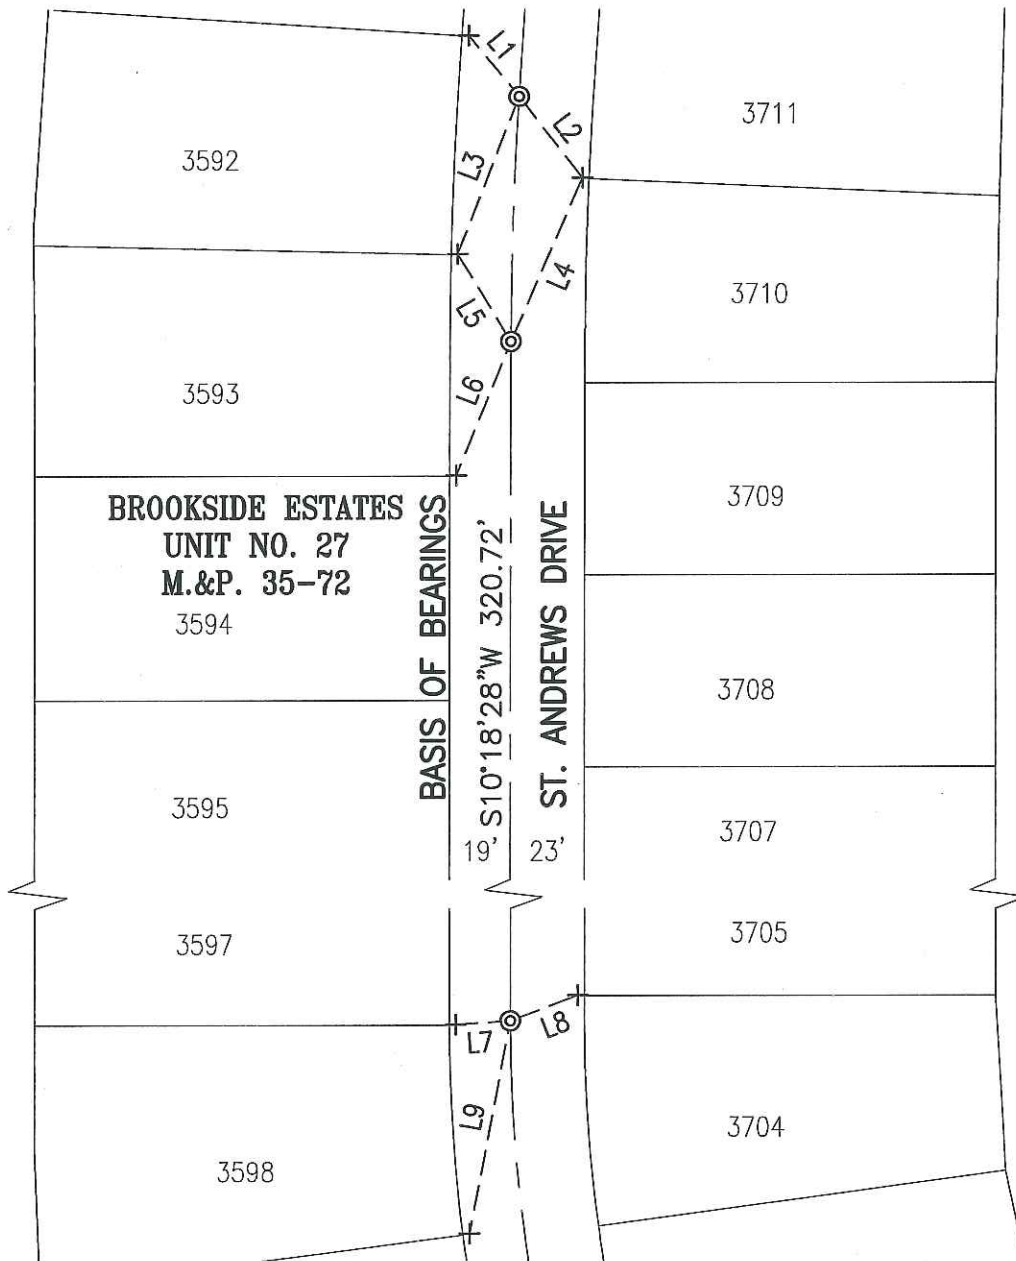

LINE TABLE		
LINE #	DIRECTION	LENGTH
L1	S29°09'11"E	24.79'
L2	N27°16'25"W	32.28'
L3	N31°25'07"E	53.06'
L4	S33°40'10"W	55.84'
L5	S21°02'21"E	32.02'

LINE TABLE		
LINE #	DIRECTION	LENGTH
L6	N32°21'39"E	45.22'
L7	S83°39'03"E	17.07'
L8	S79°23'11"W	22.49'
L9	N21°07'23"E	67.69'

