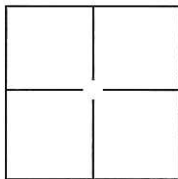


# CORNER RECORD

Document Number CR-12-25City of STOCKTONCounty of SAN JOAQUIN, CaliforniaBrief Legal Description SPANISH BAY CIRCLE, M.&P. 35-66, SEC. 31, T.2N., R.6E., M.D.B.&M.**CORNER TYPE**

|                   |                          |          |                                     |
|-------------------|--------------------------|----------|-------------------------------------|
| Government Corner | <input type="checkbox"/> | Control  | <input type="checkbox"/>            |
| Meander           | <input type="checkbox"/> | Property | <input type="checkbox"/>            |
| Rancho            | <input type="checkbox"/> | Other    | <input checked="" type="checkbox"/> |

Date of Survey DECEMBER 16, 2011**COORDINATES(Optional)**

N. \_\_\_\_\_  
E. \_\_\_\_\_  
Zone \_\_\_\_\_ NAD27 ☐ NAD83 ☐  
NAD83 Epoch \_\_\_\_\_  
Elev. \_\_\_\_\_  
Vert. Datum: NGVD29 ☐ NADV88 ☐  
Meas. Units: Metric ☐ Imperial ☐

Corner - Left as found ☐ Found and tagged ☐ Established ☐ Reestablished ☒ Rebuilt ☐

Identification and type of corner found: Evidence used to identify or procedure used to establish or reestablish the corner:

SEE PLAT ON BACK


A description of the physical condition of the monument as found and as set or reset: \_\_\_\_\_

SET 3/4", 30" LONG REBAR WITH CAP ATTACHED AND STAMPED "LS 8247" IN MONUMENT WELL.**SURVEYOR'S STATEMENT**

This Corner Record was prepared by me or under my direction in conformance with

the Land Surveyor's Act on DECEMBER 19, 2011.Signed *Laszlo Zold* P.L.S. or R.C.E. No.: 8247**COUNTY SURVEYOR'S STATEMENT**This Corner Record was received January 9, 2012 and examinedand filed February 5, 2012.Signed *Thomas M. Hume* P.L.S. or R.C.E. No.: 26994Title County Surveyor

County Surveyor's Comment \_\_\_\_\_

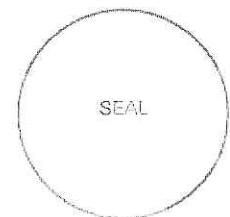

## LEGEND:


- M.&P. BOOK OF MAPS AND PLATS, VOLUME-PAGE  
+ FOUND CHISELED CROSS ON 2' OFFSET PER M.&P. 35-66  
⊙ SET ¾" REBAR, 30" LONG W/CAP ATTACHED AND STAMPED "LS 8247" IN MONUMENT WELL  
● FOUND PK NAIL W/TAG STAMPED "LS 8092" PER CORNER RECORD CR 11-112  
⊙ FOUND ¾" REBAR W/CAP ATTACHED AND STAMPED "LS 4334", NOT DISTURBED

## BASIS OF BEARINGS:

THE CENTERLINE OF SPANISH BAY CIRCLE WHICH BEARS S46°00'52"W PER M.&P. 35-66

0' 50' 100' 200'

SCALE: 1"=100'

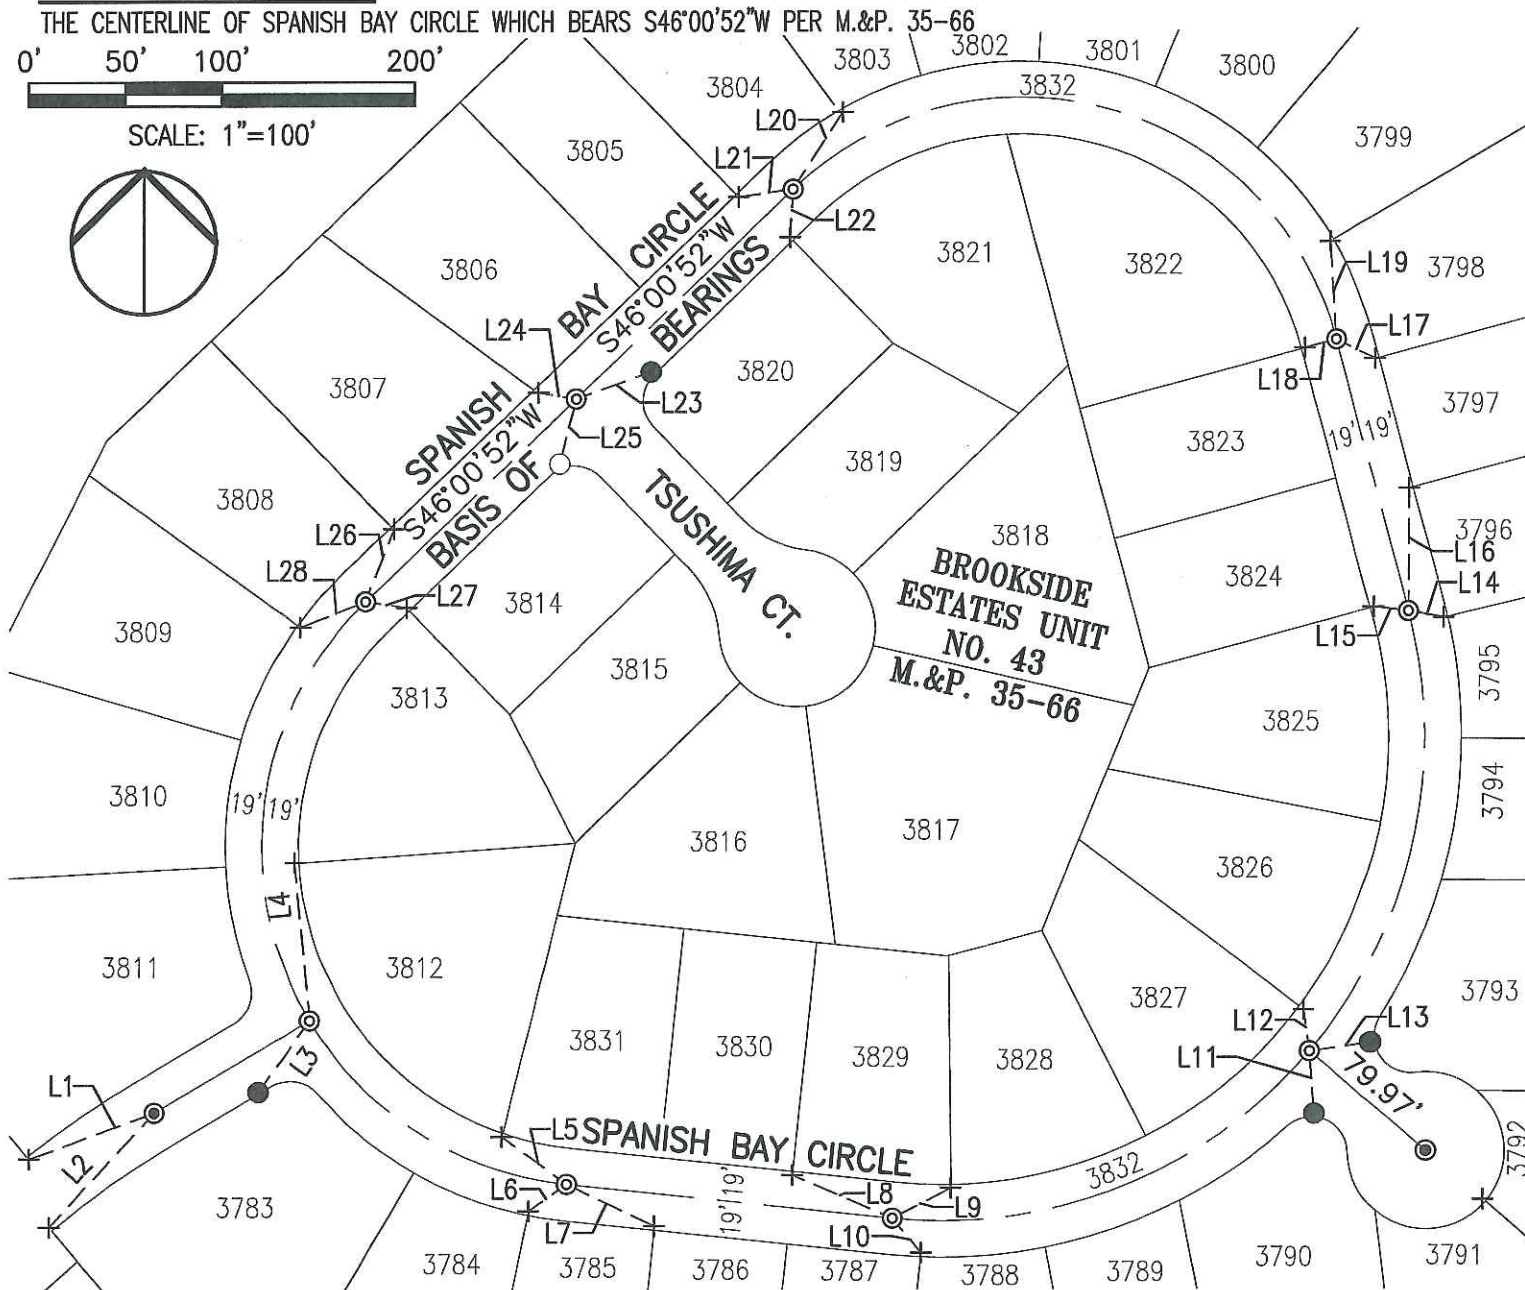

| LINE TABLE |             |        |
|------------|-------------|--------|
| LINE #     | DIRECTION   | LENGTH |
| L1         | S69°44'29"W | 69.15' |
| L2         | N42°34'25"E | 80.77' |
| L3         | S35°30'10"W | 45.74' |
| L4         | S5°20'00"E  | 82.44' |
| L5         | N53°38'27"W | 41.94' |
| L6         | N54°48'42"E | 24.44' |
| L7         | N64°31'08"W | 50.89' |

| LINE TABLE |             |        |
|------------|-------------|--------|
| LINE #     | DIRECTION   | LENGTH |
| L8         | N66°35'13"W | 56.98' |
| L9         | S62°28'36"W | 34.25' |
| L10        | S39°23'20"E | 23.42' |
| L11        | N4°07'52"W  | 32.64' |
| L12        | N8°16'33"W  | 21.85' |
| L13        | S82°05'20"W | 32.39' |
| L14        | S79°50'51"E | 18.58' |

| LINE TABLE |             |        |
|------------|-------------|--------|
| LINE #     | DIRECTION   | LENGTH |
| L15        | S83°16'32"E | 18.34' |
| L16        | N0°23'44"E  | 64.05' |
| L17        | S63°34'35"E | 22.58' |
| L18        | S75°17'45"W | 17.13' |
| L19        | S3°35'05"E  | 51.30' |
| L20        | S32°42'14"W | 47.89' |
| L21        | N81°53'46"E | 28.89' |

| LINE TABLE |             |        |
|------------|-------------|--------|
| LINE #     | DIRECTION   | LENGTH |
| L22        | S3°31'39"W  | 25.22' |
| L23        | N70°16'53"E | 41.52' |
| L24        | N80°31'23"W | 20.01' |
| L25        | S14°19'48"W | 35.13' |
| L26        | S21°04'03"W | 40.45' |
| L27        | S81°21'47"E | 21.48' |
| L28        | N68°41'35"E | 36.53' |