## **CORNER RECORD**

CORNER	RECOR	D	ocument N	umber $\cal C$	2-12-2	26	
City of STOCKTON				SAN JOAQU			 mia
Brief Legal Description Po	DPPY HILLS CIRCLE, M.8						
	CORNER T	YPE		coo	RDINATES(	Optional)	
	Government Corner  Meander  Rancho	Control Property Other		N E Zone NAD83 Epoch Elev	NAC	027 NAD83	
	Date of Survey	IBER 15, 2	2011	Vert. Datum: Meas. Units:	NGVD29 L Metric L	NADV88 Imperial	
Corner - Left as found	Found and tagged	☐ Esta	ablished	Reestablis	shed 🛚	Rebuilt 🗌	
A description of the physical co	T ON BACK	ound and as	set or reset:				  T WELL.
	SURVEYOR'S STATEMI	ENT			5101	NAL LANDS	
This Corner Record was prepared the Land Surveyor's Act on Signed	DECEMBER 19  P.L.S. or R	,201	1		Exp.	lo. 8247 2 2 2 2 2 2 2 2 2 2 2 2 2 2 2 2 2 2	
С	OUNTY SURVEYOR'S STA	TEMENT					
This Corner Record was received and filed  Signed  Title County Surveyor's Common	P.L.S. or		12_ and	examined		SEAL	

## **LEGEND:**

M.&P. BOOK OF MAPS AND PLATS, VOLUME-PAGE

+ FOUND CHISELED CROSS ON 2' OFFSET PER M.&P. 34-52

SET ¾" REBAR, 30" LONG W/CAP ATTACHED AND STAMPED "LS 8247" IN MONUMENT WELL


FOUND NAIL, NO REF.

● FOUND PK NAIL W/TAG STAMPED "LS 8092" PER CORNER RECORD CR 11-113

## **BASIS OF BEARINGS:**

THE CENTERLINE OF SPANISH BAY CIRCLE WHICH BEARS S09°15'52"W PER M.&P. 34-52

	LINE TABLE	And the second		
LINE #	DIRECTION	LENGTH		
L1	S63'47'51"W	29.64		
L2	N76°15'35"E	44.50'		
L3	S72°22'31"W	39.03		
L4	N51'52'12"E	20.06		
L5	N13°40'50"W	46.08'		
L6	N68'46'01"E	43.41'		
L7	S47'27'05"W	58.96		
L8	S17°47'45"E	37.43		
L9	N54°59'23"E	28.25'		
L10	N43°24'13"W	24.52		
L11	S42°34'30"E	24.05		
L12	L12 S26'20'25"W			
L13	.13 S42°53'08"E			
L14	.14 N25°05'58"E			

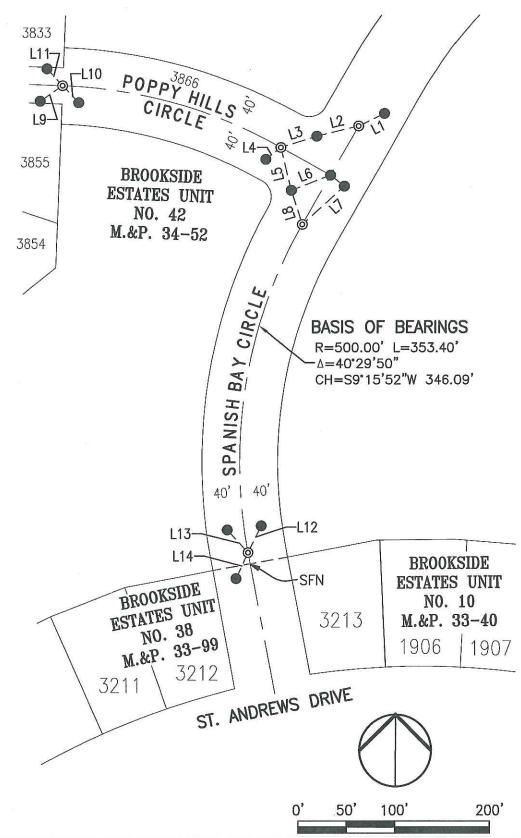

SCALE: 1"=100'