
CORNER RECORD

Document Number CR - 12-30 City of STOCKTON County of SAN JOAQUIN , California Brief Legal Description PORTIONS OF 12 PM 72, 14 PM 144, 23 PM 197 **CORNER TYPE** COORDINATES(Optional) Government Corner Control Meander Property NAD27 NAD83 Rancho Other NAD83 Epoch NGVD29 NADV88 Date of Survey Vert. Datum: Metric Imperial Meas, Units: Corner -Rebuilt Left as found Found and tagged Reestablished X Established ____ Identification and type of corner found: Evidence used to identify or procedure used to establish or reestablish the corner: FOUND ORIGINAL MONUMENTS PER 12 PM 72, 14 PM 144, AND 23 PM 197. HELD RECORD DIRECTIONS AND DISTANCES FROM STREET MONUMENTS AND FOUND IRON PINS. A description of the physical condition of the monument as found and as set or reset: FOUND OR SET AS SHOWN PER MAP. LAND SUAL SURVEYOR'S STATEMENT This Corner Record was prepared by me or under my direction in conformance with the Land Surveyor's Act on AUGUST 22 P.L.S. or R.C.E. No.: LS 7539 **COUNTY SURVEYOR'S STATEMENT** and filed P.L.S. or R.C.E. No.: Signed **County Surveyor's Comment**

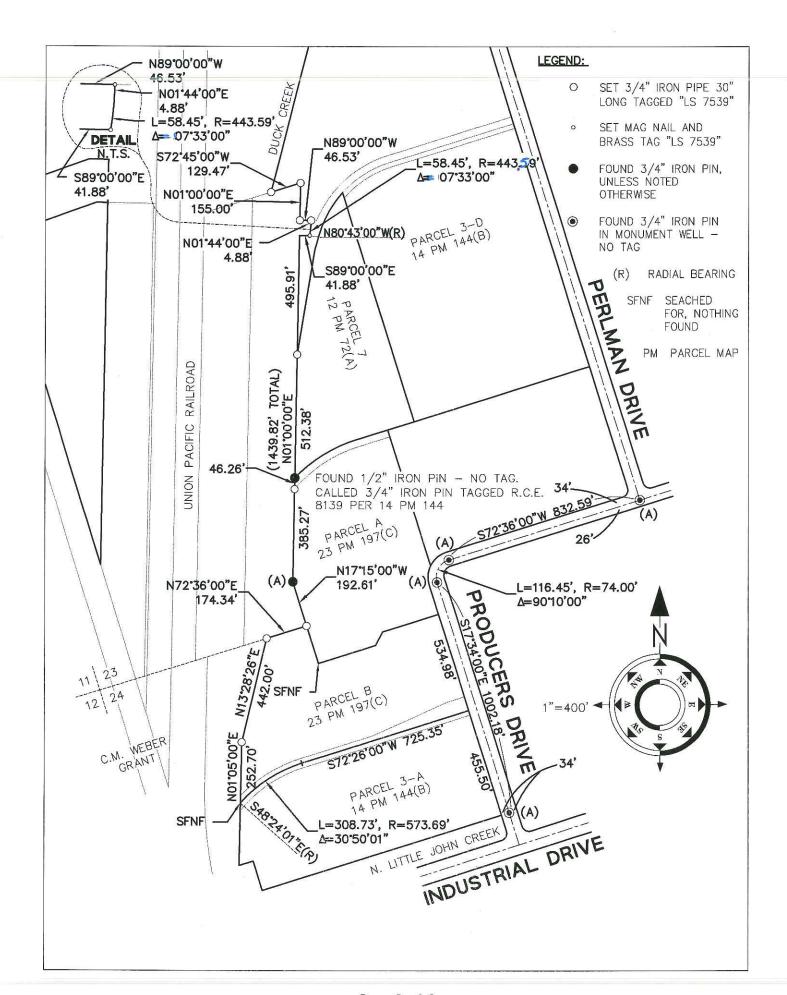

Page 2 of 2