
CORNER RECORD		Document NumberCL-1Z-57		
City of		County of	San Joaquin,	
Brief Legal Description	AVENA ROAD 2645'+/- EAST OF MURPHY ROAI	D		4
21 T1S R8E M.D.B. & M.	CORNER TYPE Government Corner	N E Zone NAD83 E Elev Vert. Dat	NAD2 poch tum: NGVD29 Chits: Metric C	7
*	nd Found and tagged Established	☐ Reesta	blished □ Rel	puilt 🛛
	sical condition of the monument as found and c	as set or reset:_		
	SURVEYOR'S STATEMENT		·	LAND
the Land Surveyors' Ad Signed James	prepared by me or under my direction in conforct on, 2012. Hack P.L.S. Number 8657 DUNTY SURVEYOR'S STATEMENT		PROP LIC	ENSE 8657
	as received <u>January 27</u> , 2012 and e			CALIFORNIA SSION
Title County Surveyo	or		PROFE ON A S	SSIONAL CIL
County Surveyor's Cor	mment		(19) No.	26994 5-31-13
(D.D. Sheet No. 45) (Job No. 220773)			ATE OF	VILARI

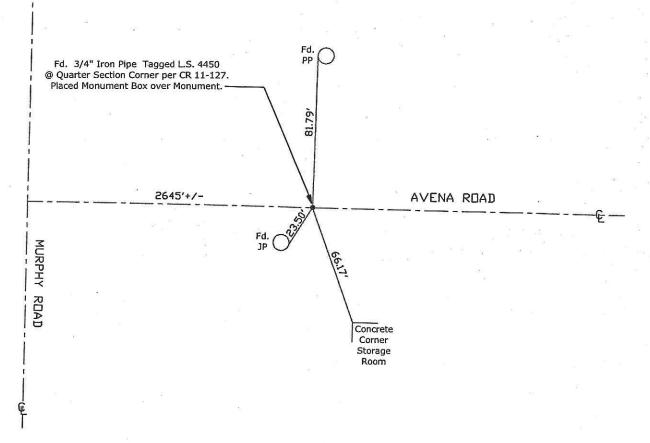

N.T.S.



Note: Found Monuments are not tagged unless otherwise noted.

"No Attempt Was Made to Verify the Monument(s)"

Set=Conc. Nail with Brass Washer Stamped
"S.J. Co.", unless otherwise noted
Fd.=Found Conc. Nail with Brass Washer Stamped
"S.J. Co.", unless otherwise noted
CR=Corner Record
FP=Fence Post
JP=Joint Pole
LP=Light Pole
PP=Power Pole
GP=Guy Pole
SP=Service Pole
TP=Telephone Pole
S.F.N.=Searched Found Nothing
N.T.S.=Not To Scale
M&P=Maps & Plats
PM=Parcel Map
RS=Record of Survey

FB=Field Book