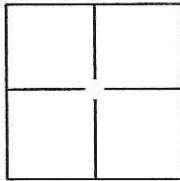


CORNER RECORD

Document Number CR-12-71City of County of San Joaquin, CaliforniaBrief Legal Description Lot "A" as shown on Page 141 of Parcel Maps in Book 5, S.J.C.R.**CORNER TYPE**

Government Corner	<input type="checkbox"/>	Control	<input type="checkbox"/>
Meander	<input type="checkbox"/>	Property	<input checked="" type="checkbox"/>
Rancho	<input type="checkbox"/>	Other	<input type="checkbox"/>

Date of Survey February 24, 2011**COORDINATES(Optional)**


N.
E.
Zone NAD27 ☐ NAD83 ☐
NAD83 Epoch
Elev.
Vert. Datum: NGVD29 ☐ NADV88 ☐
Meas. Units: Metric ☐ Imperial ☒

Corner - Left as found ☐ Found and tagged ☐ Established ☐ Reestablished ☒ Rebuilt ☐

Identification and type of corner found: Evidence used to identify or procedure used to establish or reestablish the corner.

See plat on backA description of the physical condition of the monument as found and as set or reset: Set 3/4" - 24" rebar tagged "LS 8080"**SURVEYOR'S STATEMENT**

This Corner Record was prepared by me or under my direction in conformance with

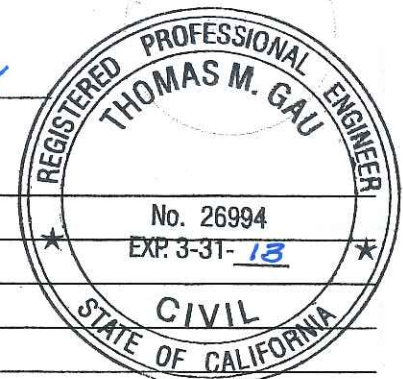the Land Surveyor's Act on February 28, 2012Signed P.L.S. or R.C.E. No.: 8080**COUNTY SURVEYOR'S STATEMENT**This Corner Record was received FEBRUARY 29, 2012 and examinedand filed MARCH 7, 2012Signed P.L.S. or R.C.E. No.: 26994Title COUNTY SURVEYORCounty Surveyor's Comment 

(A) P.M. 5-141
(B) R.S. 15-86
(C) M.&P. 22-84



PO BOX 435 LODI CA 95241-0435
(209) 747-0169 dbwsurvey@yahoo.com

PLAT OF PARCEL "A" ON P.M. 5-141
S.J.C.R.