
CORNER RECORD Document Number __CR 12-87 City of County of San Joaquin, California HILLVIEW COURT 270'+/- WEST OF HILLVIEW STREET Brief Legal Description __ (WITHIN SECTION 3, TOWNSHIP 3 SOUTH, RANGE 5 EAST) **CORNER TYPE** COORDINATES (Optional) Government Corner Control NAD27 ☐ NAD83 ☐ Zone Meander Property NAD83 Epoch_ ☐ Other Rancho \boxtimes Elev. Vert. Datum: NGVD29 □ February 2, 2012 Date of Survey Meas. Units: Metric Imperial 🛛 Left as found ☐ Found and tagged ☐ Corner -Established Reestablished Rebuilt Identification and type of comer found: Evidence used to identify or procedure used to establish or reestablish the corner: SEE SKETCH ON BACKSIDE. A description of the physical condition of the monument as found and as set or reset: SEE SKETCH ON BACKSIDE. SURVEYOR'S STATEMENT This Corner Record was prepared by me or under my direction in conformance with February 10 , 2012. the Land Surveyors' Act on ____ __ P.L.S. Number___8657 LICENSE No. 865 **COUNTY SURVEYOR'S STATEMENT** This Corner Record was received FEBWARY 10, 2012 and examined and filed MARCH , 2012. Han R.C.E. No. 26994 Title _ County Surveyor County Surveyor's Comment (D.D. Sheet No. 68)

(Job No. 220033)

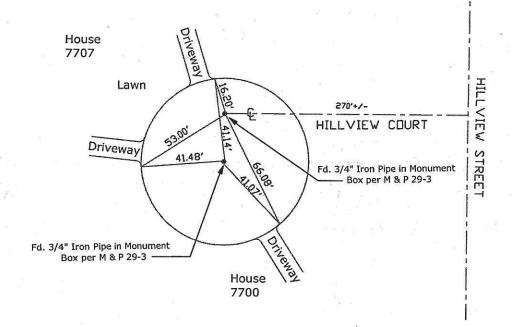

N.T.S.



Note: Found Monuments are not tagged unless otherwise noted.

"No Attempt Was Made to Verify the Monument(s)"

Set=Conc. Nail with Brass Washer Stamped
"S.J. Co.", unless otherwise noted
Fd.=Found Conc. Nail with Brass Washer Stamped
"S.J. Co.", unless otherwise noted
CR=Corner Record
FP=Fence Post
JP=Joint Pole
LP=Light Pole
PP=Power Pole PP=Power Pole GP=Guy Pole SP=Service Pole SP=Service Pole
TP=Telephone Pole
S.F.N.=Searched Found Nothing
N.T.S.=Not To Scale
M&P=Maps & Plats
PM=Parcel Map
RS=Record of Survey
FB=Field Book