

# CORNER RECORD

Document Number CR 12-110  
County of SAN JOAQUIN, California

City of LATHROP

Brief Legal Description SURVEY MONUMENT AT THE INTERSECTION OF YOSEMITE AVE, VIERRA ROAD AND MCKINLEY AVE. THE APPARENT SOUTHEAST CORNER OF SECTION 35, T.1S., R.6E., M.D.B.&M.

## CORNER TYPE

## COORDINATES (Optional)

NW 1/4	NE 1/4
SW 1/4	SE 1/4

SEC. 35 T.1S, R.6E

Government Corner ☐ Control ☐  
Meander ☐ Property ☐  
Rancho ☐ Other ☒

Date of Survey 02-14-2012

N \_\_\_\_\_  
E \_\_\_\_\_  
Zone \_\_\_\_\_ NAD27 ☐ NAD83 ☐  
NAD83 Epoch \_\_\_\_\_  
Elev. \_\_\_\_\_  
Vert. Datum: NVGD29 ☐ NVGD88 ☐  
Meas. Units: Metric ☐ Imperial ☐

Corner— Left as found ☒ Found and tagged ☐ Established ☐ Reestablished ☐ Rebuilt ☐

Identification and type of corner found: Evidence used to identify or procedure used to establish or reestablish the corner:  
FOUND 2 1/2" BRASS DISK STAMPED LS 6314 IN MONUMENT WELL, AT THE INTERSECTION OF YOSEMITE AVENUE, VIERRA ROAD AND MCKINLEY AVENUE, THE APPARENT SOUTHEAST CORNER OF SECTION 35, T.1S, R.6E., M.D.B.&M. FOUND MONUMENT IN LOCATION AS SHOWN ON RECORD OF SURVEY FILED IN BOOK 36 OF SURVEYS AT PAGE 23, SAN JOAQUIN COUNTY RECORDS.

A description of the physical condition of the monument as found and as set or reset:  
MONUMENT IS IN AREA OF RECONSTRUCTION, SET TIES AS SHOWN ON PAGE 2.

## SURVEYOR'S STATEMENT

This Corner Record was prepared by me or under my direction in conformance with the Land Surveyors' Act on FEBRUARY 27, 2012,

Signed [Signature] P.L.S. or R.C.E. Number 6953




## COUNTY SURVEYOR'S STATEMENT

This Corner Record was received MARCH 15, 2012 and examined and filed MARCH 19, 2012.

Signed [Signature] P.L.S. or R.C.E. No: 26994

Title COUNTY SURVEYOR

County Surveyor's Comment \_\_\_\_\_

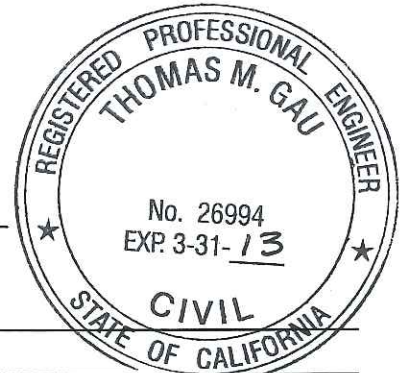

SECTION 36  
T.1S.,R.6E.

SECTION 1  
T.2S.,R.6E.

FOUND 2 1/2" BRASS DISK  
STAMPED L.S. 6314  
IN MONUMENT WELL.(R1)

McKINLEY AVENUE

SECTION 35  
T.1S.,R.6E.

SECTION 2  
T.2S.,R.6E.

SET NAIL WITH BRASS TAG  
LS 6953, 0.5'± NORTH  
OF CENTERLINE ROAD

114.97'(M)

325.90'(M)

111.21'(M)

SET NAIL WITH BRASS TAG  
LS 6953, 1.5'± NORTH  
OF CENTERLINE ROAD

VIERRA ROAD

99.72'(M)

SET NAIL WITH BRASS TAG  
LS 6953, 1.5'± NORTH  
OF CENTERLINE ROAD

YOSEMITE AVENUE

NOT TO SCALE

REFERENCE:

(R1) R.S. 36-23, S.J.C.R.

LEGEND:



SET MONUMENT AS NOTED  
FOUND MONUMENT AS NOTED.

S.J.C.R.

DENOTES SAN JOAQUIN COUNTY RECORDS

R.S.

DENOTES RECORD OF SURVEY, BOOK-PAGE, S.J.C.R.

(M)

MEASURED DISTANCE. ALL DISTANCES ARE MEASURED  
UNLESS NOTED OTHERWISE.