
CORNER RECORD Document Number CR - 12-175 City of ____ County of San Joaquin, California BRANDT ROAD 2640' +/- EAST OF TULLY ROAD Brief Legal Description _ (WITHIN SECTION 5, TOWNSHIP 3 NORTH, RANGE 8 EAST) **CORNER TYPE** COORDINATES (Optional) Government Corner Control Zone NAD27 ☐ NAD83 ☐ Meander Property NAD83 Epoch_ Rancho Other X Elev.__ Vert. Datum: NGVD29 □ NAVD88 April 25, 2012 Date of Survey ___ Meas. Units: Metric Imperial 🛛 Corner -Left as found ☐ Found and tagged ☐ Established Reestablished Rebuilt Identification and type of corner found: Evidence used to identify or procedure used to establish or reestablish the corner: SEE SKETCH ON BACKSIDE. A description of the physical condition of the monument as found and as set or reset: SEE SKETCH ON BACKSIDE. SURVEYOR'S STATEMENT This Corner Record was prepared by me or under my direction in conformance with the Land Surveyors' Act on _____ April 27 tames E- Hart P.L.S. Number 8657 No. 865 COUNTY SURVEYOR'S STATEMENT This Corner Record was received April 30 _, 2012 and examined and filed 2012. _____R.C.E. No. <u>26994</u> Title County Surveyor County Surveyor's Comment_____ No. 26994 (D.D. Sheet Nos. 9 & 18)

(Job No. 220021)

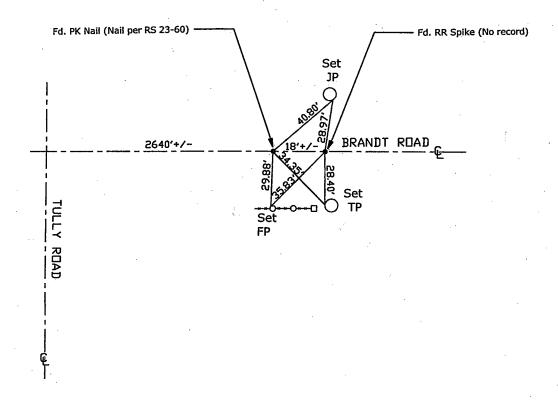

N.T.S.



Note: Found Monuments are not tagged unless otherwise noted.

"No Attempt Was Made to Verify the Monument(s)"

Set=Conc. Nail with Brass Washer Stamped
"S.J. Co.", unless otherwise noted
Fd.=Found Conc. Nail with Brass Washer Stamped
"S.J. Co.", unless otherwise noted
CR=Corner Record
FP=Fence Post
JP=Joint Pole
LP=Light Pole
PP=Power Pole
GP=Guy Pole
SP=Service Pole
TP=Telephone Pole
SF.N.=Searched Found Nothing
N.T.S.=Not To Scale
M&P=Maps & Plats
PM=Porcel Map
RS=Record of Survey
FB=Field Book