
## **CORNER RECORD**

CAN C SAN	The second secon
	JOAQUIN , California
Brief Legal Description SURVEY MONUMENT AT THE INTERSECTION OF YOSEMI	
AND McKINLEY AVE. THE APPARENT SOUTHEAST CORNER OF SECTION 35, T.1S	
1/4   1/4	NAD27 NAD83 Coptional)  NAD27 NAD83 Coptional  Epoch NAD29 NVGD88 Coptional
Corner— Left as found  Found and tagged  Established  R	eestablished 🛛 Rebuilt 🗌
Identification and type of corner found: Evidence used to identify or procedure used to	establish or reestablish the corner:
SET 2 1/2" BRASS DISK STAMPED LS 6953 IN MONUMENT WELL, AT THE IN	FERSECTION OF YOSEMITE
AVENUE, VIERRA ROAD AND McKINLEY AVENUE, THE APPARENT SOUTHEAST CO	ORNER OF SECTION 35, T.1S,
R.6E., M.D.B.&M. MONUMENT WAS DESTROYED DURING CONSTRUCTION. FOUND	WITNESS CORNERS AS SHOWN
ON CORNER RECORD DOCUMENT NUMBER 12-110.	
A description of the physical condition of the monument as found and as set or reset:  SET 2 1/2" BRASS DISK IN MONUMENT WELL STAMPED L.S. 6953 FROM TIES	
SURVEYOR'S STATEMENT	LAMP
	ENT A. HIDE
This Corner Record was prepared by me or under my direction in conformance with the Land Surveyors' Act on	N□. 6953 EXP. 9-30-2013
	NII. 6953 EXP. 9-30-2013

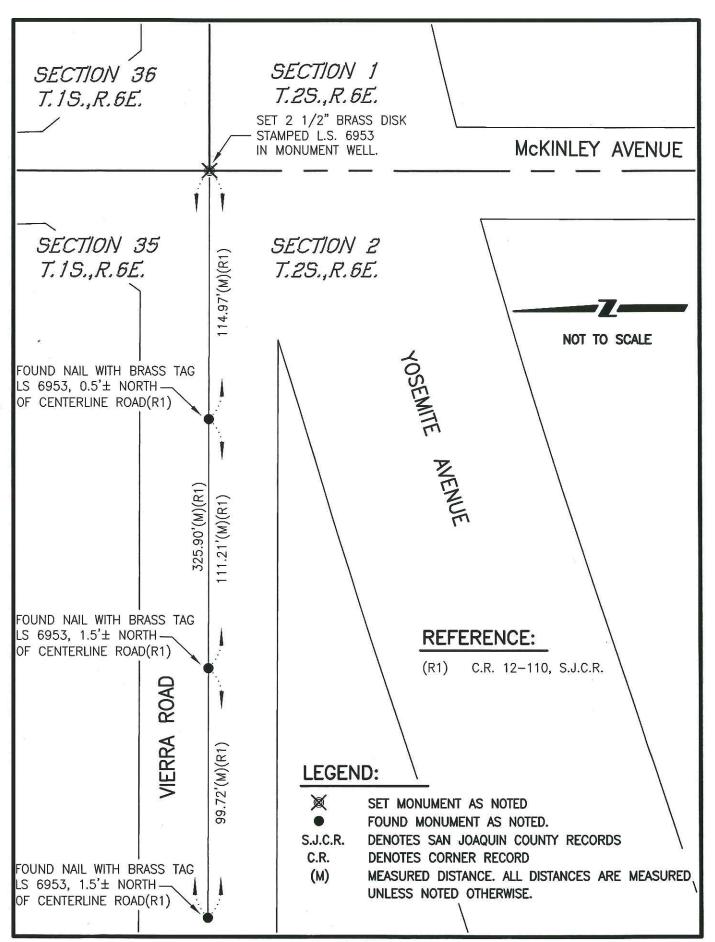

Page 2 of 2