

CORNER RECORD

Document Number CR-12-221City of STOCKTONCounty of SAN JOAQUIN, CaliforniaBrief Legal Description CITY OF STOCKTON CONTROL MONUMENT AND TWO PROPERTY CORNERS AT THE NORTHWEST AND SOUTHWEST CORNERS OF HENRY LONG BLVD AND MANTHEY ROAD.**CORNER TYPE****COORDINATES (Optional)**

NW 1/4	NE 1/4
SW 1/4	SE 1/4

SEC. 12
C.M. WEBER GRANT

Government Corner	<input type="checkbox"/>	Control	<input checked="" type="checkbox"/>
Meander	<input type="checkbox"/>	Property	<input checked="" type="checkbox"/>
Rancho	<input type="checkbox"/>	Other	<input type="checkbox"/>

Date of Survey 6-18-2012

N	_____
E	_____
Zone	_____ NAD27 <input type="checkbox"/> NAD83 <input type="checkbox"/>
NAD83 Epoch	_____
Elev.	<u>21.65</u>
Vert. Datum:	NVGD29 <input type="checkbox"/> NVGD88 <input checked="" type="checkbox"/>
Meas. Units:	Metric <input type="checkbox"/> Imperial <input type="checkbox"/>

Corner— Left as found ☒ Found and tagged ☐ Established ☐ Reestablished ☐ Rebuilt ☐

Identification and type of corner found: Evidence used to identify or procedure used to establish or reestablish the corner:
FOUND 2-1/2" BRASS DISC IN WELL STAMPED "CITY OF STOCKTON 8S-24", FOUND ONE 1" IRON PIN WITH BRASS TAG RCE 8189 AND ONE 3/4" REBAR NOT TAGGED OF THE AT THE INTERSECTION OF MANTHEY ROAD AND HENRY LONG BLVD. LOCATED IN SECTION 12 OF THE C.M. WEBER GRANT. FOUND MONUMENTS AS SHOWN ON RECORDS OF SURVEY FILED IN BOOK 35 AT PAGE 5, BOOK 31 AT PAGE 164 AND BOOK 27 AT PAGE 137 OF SURVEYS, SAN JOAQUIN COUNTY RECORDS.

A description of the physical condition of the monument as found and as set or reset:
MONUMENTS ARE IN AREA OF RECONSTRUCTION, SET TIES AS SHOWN ON PAGE 2.

SURVEYOR'S STATEMENT


This Corner Record was prepared by me or under my direction in conformance with the Land Surveyors' Act on JULY 10, 2012,

Signed [Signature] P.L.S. or R.C.E. Number 6953**COUNTY SURVEYOR'S STATEMENT**

This Corner Record was received AUGUST 13, 2012 and examined and filed SEPTEMBER 18, 2012.

Signed Thomas M. Gau P.L.S. or R.C.E. No: 26994Title COUNTY SURVEYOR

County Surveyor's Comment _____

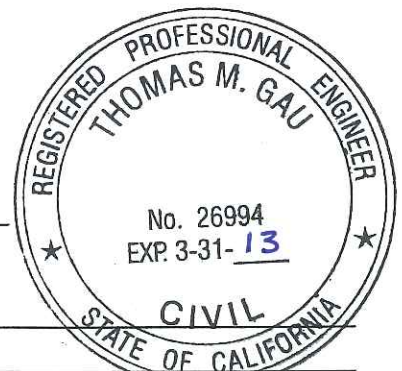

REFERENCES:

- (R1) R.S. 35-5, S.J.C.R.
 (R2) R.S. 31-164, S.J.C.R.
 (R3) R.S. 27-137, S.J.C.R.

LEGEND:



SET MONUMENT AS NOTED.



FOUND MONUMENT AS NOTED.

S.J.C.R.

DENOTES SAN JOAQUIN COUNTY RECORDS

R.S.

DENOTES RECORD OF SURVEY, BOOK-PAGE, S.J.C.R.

COS

DENOTES CITY OF STOCKTON

(M)

MEASURED DISTANCE. ALL DISTANCES ARE MEASURED UNLESS NOTED OTHERWISE.

