

CORNER RECORD

Document Number CR-12-222City of STOCKTONCounty of SAN JOAQUIN, CaliforniaBrief Legal Description MONUMENTS ON HENRY LONG BLVD. APPROXIMATELY 389'± WEST OF MANTHEY ROAD AND HENRY LONG BLVD. LOCATED IN SECTION 12 OF THE C.M. WEBER GRANT.

CORNER TYPE

COORDINATES (Optional)

NW 1/4	NE 1/4
SW 1/4	SE 1/4

SEC. 12
C.M. WEBER GRANT

Government Corner ☐ Control ☐
Meander ☐ Property ☒
Rancho ☐ Other ☐

Date of Survey 6-18-2012

N _____
E _____
Zone _____ NAD27 ☐ NAD83 ☐
NAD83 Epoch _____
Elev. _____
Vert. Datum: NVGD29 ☐ NVGD88 ☐
Meas. Units: Metric ☐ Imperial ☐

Corner— Left as found ☒ Found and tagged ☐ Established ☐ Reestablished ☐ Rebuilt ☐

Identification and type of corner found: Evidence used to identify or procedure used to establish or reestablish the corner:
FOUND CONCRETE NAIL. NOT TAGGED AND A 1" IRON PIPE, NOT TAGGED ON MANTHEY ROAD APPROXIMATELY 389'± WEST OF THE INTERSECTION OF MANTHEY ROAD AND HENRY LONG BLVD. LOCATED IN SECTION 12, OF THE C.M. WEBER GRANT. FOUND MONUMENTS AS SHOWN ON RECORDS OF SURVEY FILED IN BOOK 31 AT PAGE 164 AND BOOK 27 AT PAGE 137 OF SURVEYS, SAN JOAQUIN COUNTY RECORDS.

A description of the physical condition of the monument as found and as set or reset:
MONUMENTS ARE IN AREA OF RECONSTRUCTION, SET TIES AS SHOWN ON PAGE 2.

SURVEYOR'S STATEMENT

This Corner Record was prepared by me or under my direction in conformance with
the Land Surveyors' Act on JULY 10, 2012,


Signed [Signature] P.L.S. or R.C.E. Number 6953

COUNTY SURVEYOR'S STATEMENT

This Corner Record was received AUGUST 13, 2012 and examined
and filed SEPTEMBER 18, 2012.

Signed [Signature] P.L.S. or R.C.E. No: 26994Title COUNTY SURVEYOR

County Surveyor's Comment _____

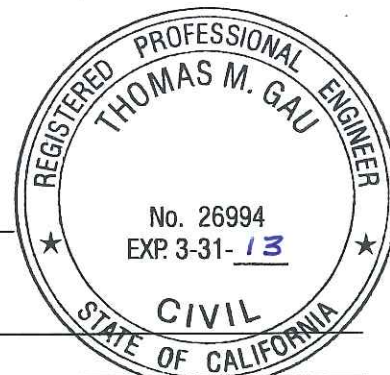

REFERENCES:

- (R1) R.S. 35-05, S.J.C.R.
 (R2) R.S. 31-164, S.J.C.R.
 (R3) R.S. 23-191, S.J.C.R.

