
Document Number __CR-12-258 CORNER RECORD County of City of ___ San Joaquin. Brief Legal Description BATES ROAD - 1309' ± EAST OF FAIROAKS ROAD (WITHIN SECTION 3, TOWNSHIP 3 SOUTH, RANGE 5 EAST, MOUNT DIABLO BASE & MERIDIAN) **CORNER TYPE** COORDINATES (Optional) Government Corner Control NAD27 ☐ NAD83 ☐ Zone Property Meander NAD83 Epoch_ Other Rancho Elev. Vert. Datum: NGVD29 NAVD88 Date of Survey __May 10, 2012 Meas. Units: Metric Imperial 🖾 Left as found ☐ Found and tagged ☐ Established ☐ Corner -Reestablished Rebuilt Identification and type of corner found: Evidence used to identify or procedure used to establish or reestablish the corner; SEE SKETCH ON BACKSIDE. A description of the physical condition of the monument as found and as set or reset: SEE SKETCH ON BACKSIDE. SURVEYOR'S STATEMENT This Corner Record was prepared by me or under my direction in conformance with September 13 the Land Surveyors' Act on P.L.S. Number <u>8657</u> Signed COUNTY SURVEYOR'S STATEMENT This Corner Record was received September 14, 2012 and examined and filed DECEIMBER **27** , 2012. ____R.C.E. No. <u>26994</u> Title County Surveyor County Surveyor's Comment_ THIS CORNER RECORD IS NOT IN COMPLIANCE WITH BOARD RULE 464(c) No. 26994 REGARDING SUBMITTAL WITHIN 90 DAYS FROM THE DATE OF SURVEY.

(D.D. Sheet No. 68) (Job No. 220816)

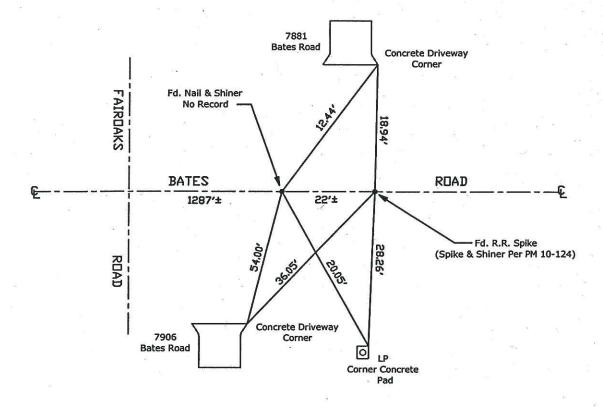

N.T.S.



Note: Found Monuments are not tagged unless otherwise noted.

"No Attempt Was Made to Verify the Monument(s)"

Set=Conc. Nail with Brass Washer Stamped
 "S.J. Co.", unless otherwise noted

Fd.=Found Conc. Nail with Brass Washer Stamped
 "S.J. Co.", unless otherwise noted

CR=Corner Record

FP=Fence Post
 JP=Joint Pole
 LP=Light Pole
 LP=Light Pole
 PP=Power Pole
 GP=Guy Pole
 SP=Service Pole
 TP=Telephone Pole
 S.F.N.=Searched Found Nothing
 N.T.S.=Not To Scale
 M&P=Maps & Plats
 PM=Parcel Map
 RS=Record of Survey
 FB=Field Book
 DW=Driveway