
CORNER RECORD Document Number CR-12-340 City of _____ County of San Joaquin, DAVIS ROAD 3940' +/- NORTH OF WOODBRIDGE ROAD Brief Legal Description _ (WITHIN SECTION 29, TOWNSHIP 4 NORTH, RANGE 6 EAST, MOUNT DIABLO BASE & MERIDIAN) **CORNER TYPE** COORDINATES (Optional) Government Corner Control Zone ____ NAD27 NAD83 Meander Property NAD83 Epoch_ Rancho Other Elev. Vert. Datum: NGVD29 □ NAVD88 September 11, 2012 Date of Survey ___ Meas. Units: Metric Imperial 🖾 Corner -Left as found ☐ Found and tagged ☐ Established Reestablished Rebuilt Identification and type of corner found: Evidence used to identify or procedure used to establish or reestablish the corner: SEE SKETCH ON BACKSIDE. A description of the physical condition of the monument as found and as set or reset: SEE SKETCH ON BACKSIDE. SURVEYOR'S STATEMENT This Corner Record was prepared by me or under my direction in conformance with the Land Surveyors' Act on _____October 8 , 2012. ___ P.L.S. Number___ 8657 LICENSE Signed_ No. 865 **COUNTY SURVEYOR'S STATEMENT** This Corner Record was received October 8, 2012 and examined and filed DECEMBER 24 , 2012. Face R.C.E. No. 26994 Signed _ Mons Title County Surveyor County Surveyor's Comment No. 26994

(D.D. Sheet Nos. 12 & 13)

(Job No.

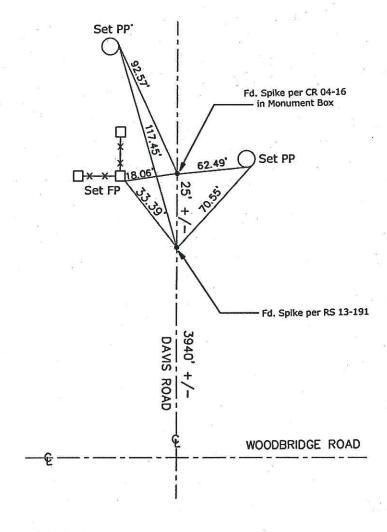

N.T.S.



Note: Found Monuments are not tagged unless otherwise noted.

"No Attempt Was Made to Verify the Monument(s)"

Set=Conc. Nail with Brass Washer Stamped
 "S.J. Co.", unless otherwise noted

Fd.=Found Conc. Nail with Brass Washer Stamped
 "S.J. Co.", unless otherwise noted

CR=Corner Record

FP=Fence Post
 JP=Joint Pole
 LP=Light Pole
 PP=Power Pole
 GP=Guy Pole
 SP=Service Pole
 IP=Telephone Pole
 S.F.N.=Searched Found Nothing
 N.T.S.=Not To Scale
 M&P=Maps & Plats
 PM=Parcel Map
 RS=Record of Survey
FB=Field Book