


CORNER RECORD

Document Number CR-12-387
City of Manteca County of San Joaquin, California

Brief Legal Description Northwest quarter of Section 8 per Book 40 of Maps & Plats, Page 24, S.J.C.R.

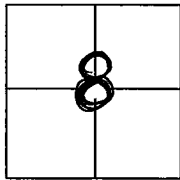

T.2S., R.7E.

CORNER TYPE

Government Corner ☐ Control ☐
Meander ☐ Property ☐
Rancho ☐ Other ☒

Date of Survey June 29, 2012

COORDINATES(Optional)

N. _____
E. _____
Zone _____ NAD27 ☐ NAD83 ☐
NAD83 Epoch _____
Elev. _____
Vert. Datum: NGVD29 ☐ NADV88 ☐
Meas. Units: Metric ☐ Imperial ☒


Corner - Left as found ☒ Found and tagged ☐ Established ☐ Reestablished ☐ Rebuilt ☐

Identification and type of corner found: Evidence used to identify or procedure used to establish or reestablish the corner:
SEE SKETCH ON PAGE 2

A description of the physical condition of the monument as found and as set or reset:
SEE SKETCH ON PAGE 2

SURVEYOR'S STATEMENT

This Corner Record was prepared by me or under my direction in conformance with
the Land Surveyor's Act on July 30th, 2012.
Signed Douglas F. Banks P.L.S. ~~or R.C.E.~~ No.: 8159

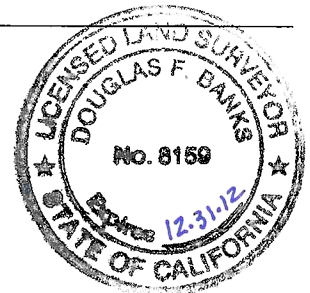

COUNTY SURVEYOR'S STATEMENT

This Corner Record was received OCTOBER 25, 2012 and examined
and filed NOVEMBER 15, 2012.
Signed Thomas M. Gau P.L.S. or R.C.E. No.: 26994
Title COUNTY SURVEYOR
County Surveyor's Comment _____

