
CORNER RECORD

CORNER RECORD	Document Number CR-12-436
City of RIPON	County of SAN JOAQUIN , California
Brief Legal Description MONUMENT AT THE INTERSECTIO	
	DUARTER OF SECTION 19, T.2S, R.8E, M.D.B.&M.
CORNER TYPE	COORDINATES (Optional)
NW NE Government Corner Control	N
1/4 1/4 Government Corner Control Meander Proper	
SW SE Rancho Other	
1/4 1/4	Elev.
SEC. 19 T.2S, R.8E Date of Survey 9-10-	—2012 Vert. Datum: NVGD29 ☐ NVGD88 ☐ Meas. Units: Metric ☐ Imperial ☐
Corner— Left as found 🔀 Found and tagged 🗌	Established Reestablished Rebuilt
Identification and type of corner found: Evidence used to iden	ntify or procedure used to establish or reestablish the corner
FOUND 3/4" IRON PIPE TAGGED L.S. 5764 IN MONUME	ENT WELL, AT THE INTERSECTION OF COLONY ROAD
AND GOODWIN DRIVE LOCATED IN THE NORTHWEST QUAR	ARTER OF SECTION 19, T.2S, R.8E, M.D.B.&M.
FOUND MONUMENT AS SHOWN ON RECORD OF SURVEY	/ FILED IN BOOK 34 OF SURVEYS AT PAGE 122,
SAN JOAQUIN COUNTY RECORDS.	
MONUMENT IS IN AREA OF RECONSTRUCTION, SET TIES	S AS SHOWN ON PAGE 2.
SURVEYOR'S STATEMENT	SED LAND SUPL
This Corner Record was prepared by me or under my direction	n in conformance with
the Land Surveyors' Act on	
Signed P.L.S. or R.C.E. N	Number 6953
COUNTY SURVEYOR'S STATEME	ENT ENT D. LUCE
This Corner Record was received November 20, 2	2012 and examined No. 4440
and filed DECEMBER 13 , 2012	9-30-13
Signed P.L.S. or R.C.E.	. No: 4440
	OF CALIFORNIA
Title Asst. County Surveyor	OF CALIFORNIE
	OF CALFORNIT
Title Asst. County Surveyor	OF CALFORNIT

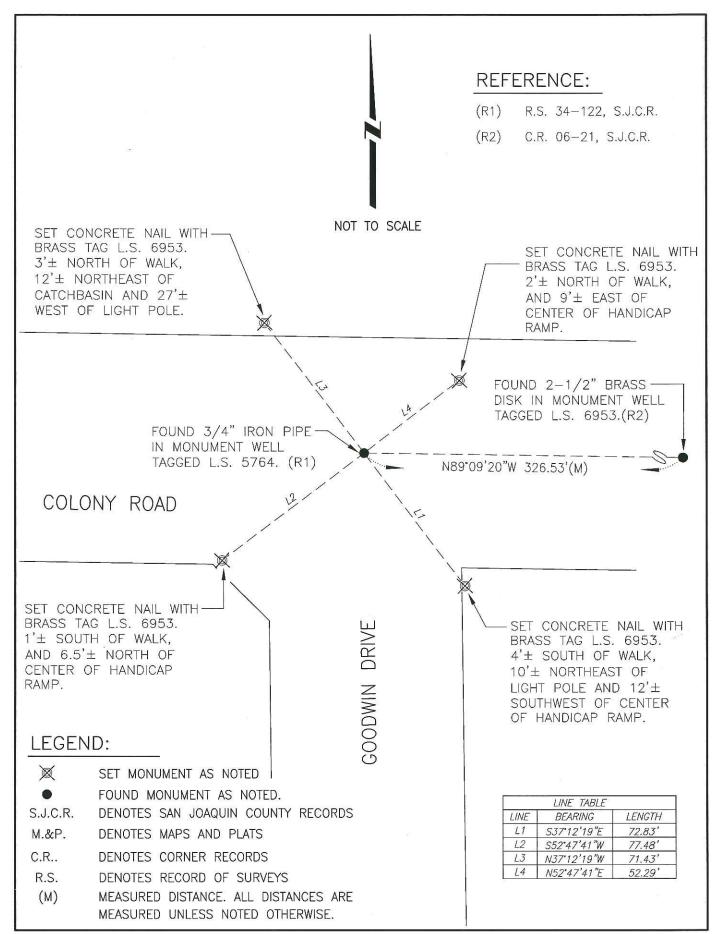

Page 2 of 2