
CORNER RECORD

	JKNEK	RECORI	J	Doc	ument N	Number <u>CR-12-439</u>
City of	R	PON				SAN JOAQUIN , California
18.0			INTER		850	ROAD AND HOFF DRIVE
			Contract to the Contract		OF SEC	TION 18, T.2S, R.8E, M.D.B.&M.
		CORI	NER T	YPE		COORDINATES (Optional)
	NE	Government Corner	П	Control		N
1/4	1/4	Meander		Property		E
	SE	Rancho		Other	\boxtimes	NAD83 Epoch
1/4	1,000					Elev.
SEC. 18	T.2S, R.8E	Date of Survey _	9	9-10-2012		Vert. Datum: NVGD29 NVGD88 Meas. Units: Metric Imperial
Corner-	Left as foun	d 🛛 Found and	tagged	Establi	shed	Reestablished Rebuilt
Identification	n and type of co	rner found: Evidence	used t	o identify or	procedure	used to establish or reestablish the corn
	NTS AS SHOWN				100	
	y'	A STANDARD CO. STA				
						0
747						or reset:
MONUMEN	NT IS IN AREA	OF RECONSTRUCTION	V, SEI	TIES AS SE	HOWN ON	PAGE 2.
						
						TAND
		SURVEYOR'S S	TATEME	ENT		LAND SURVEY A. HISTORY
This Corner	Record was pre	pared by me or under	my di	rection in cor	formance	with
						ND, 6953
the Land S	urveyors' Act on	SEPTEMBER	28,	,2012		EXP. 9-30-2013
	. 1	/				OF CALIFORN
Signed	Mary	P.L.	S. or T	R.C.E. Number	69	53
		COUNTY SURVEYOR	r's st	ATEMENT		WAL LAND
This Corner	Record was rec	eived O CTOBE	R 4	1. 200	un and	d examined
and filed _	MOUEME	BEN 8 2	012		د افراد	No. 4440 Expires
Signed	180	1		R.C.E. No:	49	9-30-13
Title	sst. Cou	wty some	you			TE OF CALFURNIS
County Sur	veyor's Commen		2			
V 						

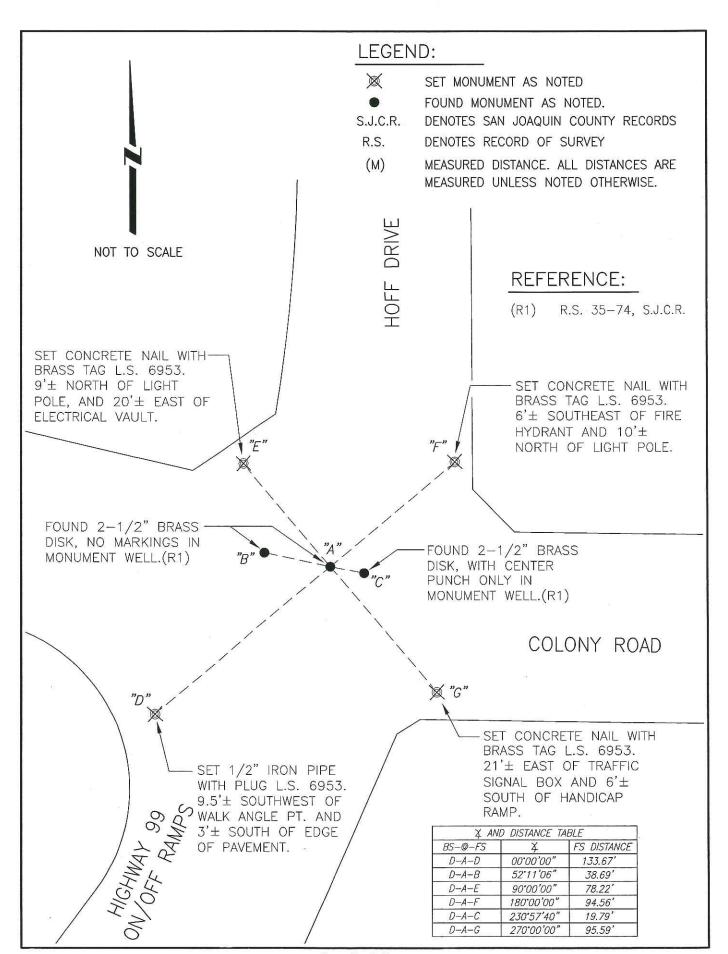

Page 2 of 2