
CORNER RECORD

CORNER	RECORD	Document	Number <u>CR-12-440</u>
City of	RIPON	County of	SAN JOAQUIN , Californ
7.70			TONE ROAD AND HOFF DRIVE
			CTION 18, T.2S, R.8E, M.D.B.&M.
P - 22 4000	CORNER	TYPE	COORDINATES (Optional)
NW NE 1/4 1/4	Government Corner	Control	N E
 	Meander	Property	ENAD27 NAD83
SW SE	Rancho	Other 🔀	NAD83 Epoch
1/4 1/4	Date of Survey	8-31-2012	Elev. Vert. Datum: NVGD29 NVGD88
SEC. 18 T.2S, R.8E	Date of Survey	0 0/ 20/2	Meas. Units: Metric Imperial
Corner— Left as fou	nd 🛛 Found and tagge	ed Established	Reestablished Rebuilt
Identification and type of a	corner found: Evidence used	to identify or procedur	e used to establish or reestablish the cor
MONUMENTS AS SHOWN			
A description of the physic	cal condition of the monumer	nt as found and as set	or reset:
	OF RECONSTRUCTION, SE		
The state of the s		The state of the s	
			5"
	SURVEYOR'S STATEM	AENT	CED LAND SUGA
			ESTENT A. HYDE
This Corner Record was pr	epared by me or under my	direction in conformanc	II I
the Land Surveyors' Act or	SEPTEMBER 28,		ND, 6953 EXP, 9-30-2013
			ZA, 7 30 E013
1			ATE DE CALEDRA
Signed Your	hour PIS or	R.C.E. Number69	953
Signed	1.L.3. 01	N.O.L. Number	
	COUNTY SURVEYOR'S S		CONAL LAND
This Corner Record was re	ceived <u>OCTOBEN</u>	4, 2012	nd examined
and filed NOVEN	BEX 8, 2012		No. 4440 Expires
Signed	Henry P.L.S.	or R.C.E. No:	1440 4 0-30-13
Title Asst. Cou	nty Suweyon		OF CALFORNIA
County Surveyor's Comme	nt		
<u> </u>			

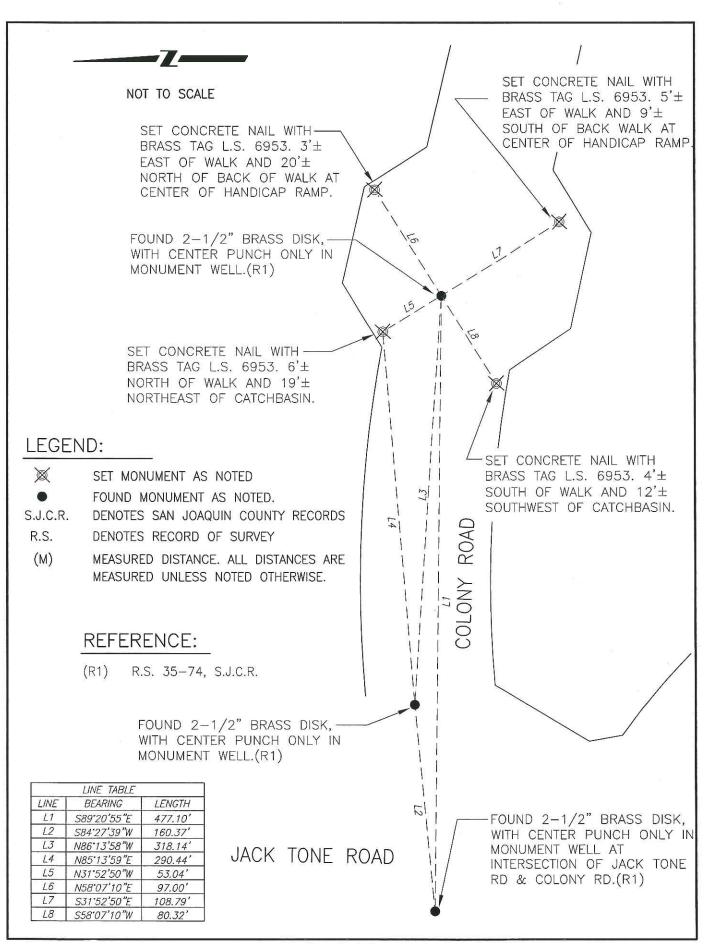

Page 2 of 2