
CORNER RECORD

COMME	\ I\LUUI\D	Document	Number <u>CR-12-44</u>
City of	WOODBRIDGE		SAN JOAQUIN , California
Brief Legal Description			STREET AND AUGUSTA STREET
NIM NE	CORNER	TIPE	COORDINATES (Optional) N
NW 1/4 1/4	Government Corner	Control	F
1	Meander	Property	ZoneNAD27 NAD83
SW SE 1/4	Rancho	Other 🔀	NAD83 Epoch
SEC. 34 T.4N, R.6E	Date of Survey	8-31-2012	Elev. Vert. Datum: NVGD29 NVGD88
			Meas. Units: Metric Imperial
Corner— Left as fo	aund 🛛 Found and tagg	ged Established	Reestablished Rebuilt
Identification and type of	corner found: Evidence use	d to identify or procedu	ire used to establish or reestablish the corne
FOUND 1" BOLT NOT	TAGGED, AT THE INTERSEC	CTION OF LILAC STRE	ET AND AUGUSTA STREET LOCATED IN
THE NORTHEAST QUAR	RTER OF SECTION 34, T.41	N, R.6E, M.D.B.&M. F	OUND MONUMENT AS SHOWN ON
PARCEL MAP FILED IN	BOOK 24 OF PARCEL M.	APS AT PAGE 10, SA	N JOAQUIN COUNTY RECORDS.
MONUMENT IS IN ARE	A OF RECONSTRUCTION, S	ET TIES AS SHOWN (ON PAGE 2.
	SURVEYOR'S STATE	MENT	LAND SURVEY A. HIGH
This Corner Record was p	prepared by me or under my	direction in conformance	
the Land Surveyors' Act of	on OCTOBER 1,	, 2012 ,	N□. 6953 EXP. 9-30-2013
.)	,		PIE OF CALEDRA
Signed	P.L.S. 0	r R.C.E. Number <u>6</u>	953
	COUNTY SURVEYOR'S	STATEMENT	WALLAW .
This Corner Record was r	received OCTOBEN	4, 2012	and examined
and filed MOVE	BER 8 701	2	No. 4440
Signed	Hund P.L.S.	or R.C.E. No:	1440 4 9-30-13
Title Asst. Coun	Ay Suveya		CALE OF CALE OF SALE
County Surveyor's Commo	ent		

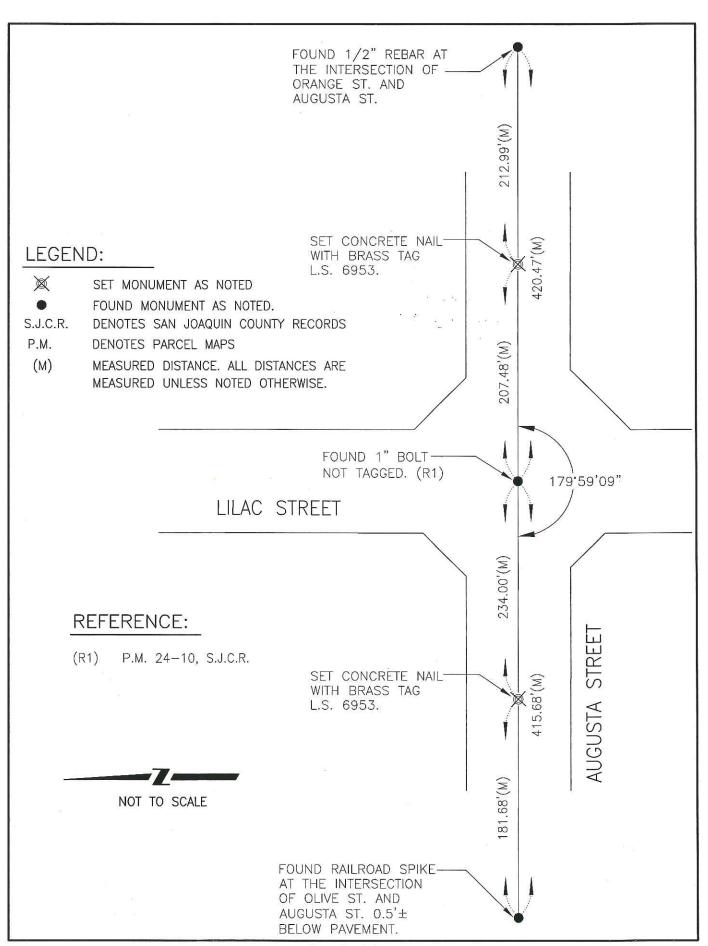

Page 2 of 2