
## **CORNER RECORD**

3 9		Document	Number <u>CR-12-942</u>
City of	WOODBRIDGE		SAN JOAQUIN , California
Brief Legal De	escription MONUMENT AT THE INTERS	SECTION OF INDIANA	A STREET AND ORANGE STREET
			ECTION 34, T.4N, R.6E, M.D.B.&M.
I NIE	CORNER TY	/RE	COORDINATES (Optional)
NW NE		Control	N E
1/4 1/4	Meander	Property	ZoneNAD27
SW SE	Rancho	Other \	NAD83 Epoch
1/4 1/4			Elev.
SEC. 34 T.41	N, R.6E Date of Survey8	-31-2012	Vert. Datum: NVGD29 NVGD88 Meas. Units: Metric Imperial
Corner- L	eft as found 🔀 Found and tagged	Established _	Reestablished Rebuilt
Identification and	d type of corner found: Evidence used t	o identify or procedu	ure used to establish or reestablish the corner:
FOUND BOLT	AND WASHER IN MONUMENT WELL, A	T THE INTERSECTION	ON OF INDIANA STREET AND ORANGE
STREET LOCAT	TED IN THE NORTHEAST QUARTER OF	SECTION 34, T.4N	N, R.6E, M.D.B.&M. FOUND MONUMENT
AS SHOWN OF	N SAN JOAQUIN COUNTY CORNER RE	CORD FILED IN BO	OOK 09 AT PAGE 73, SAN JOAQUIN
COUNTY RECC	DRDS.	1	
***			
	S IN AREA OF RECONSTRUCTION, SET		
-	SURVEYOR'S STATEME	ENT	LAND SUR
This Corner Reco	ord was prepared by me or under my dir	rection in conformanc	ce with
the Land Surveyo	ors' Act on OCTOBER 1,	, 2012 ,	N□. 6953 EXP. 9-30-2013
	1		ATE OF CALTIGUE
Signed	P.L.S. or R	<del>.C.E.</del> Number6	5953
	COUNTY SURVEYOR'S STA	ATEMENT	SONALIANOS
This Corner Reco	ord was received NOVERBEN 2	9, 2012	and examined
and filed De	ECEMBER 13 7012	11.	No. 4440 Expires
Signed	10 10	R.C.E. No:	YO WAR
Title #857.	County Suveyor		OF CALFUND
County Surveyor	's Comment		
Q			
·-			

BORPELS -1297

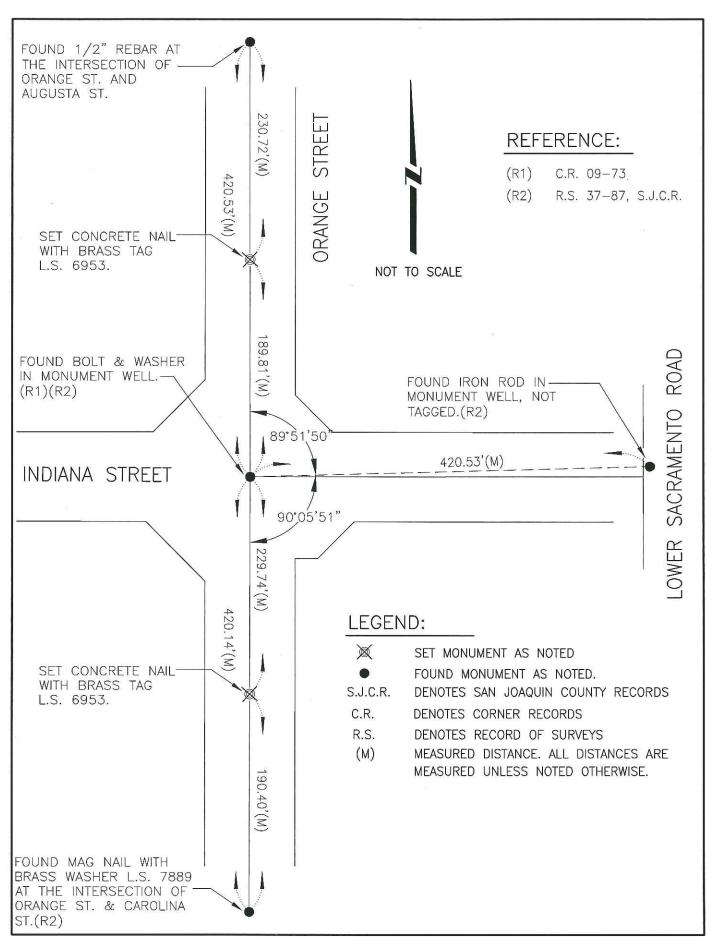

Page 2 of 2