
## CORNER RECORD Document Number \_ CR-12-467 City of \_\_\_\_\_ San Joaquin, California KOSTER ROAD 460'± NORTH OF DURHAM FERRY ROAD Brief Legal Description \_\_ WITHIN SECTION 17, TOWNSHIP 3 SOUTH, RANGE 6 EAST, MOUNT DIABLO BASE & MERIDIAN CORNER TYPE COORDINATES (Optional) Government Corner Control Zone \_\_\_ NAD27 🔲 NAD83 🔲 Meander Property NAD83 Epoch\_ Rancho Other Elev.\_ Vert. Datum: NGVD29 □ NAVD88 Date of Survey October 2, 2012 Meas, Units: Metric Imperial 🖾 Left as found **☒** Found and tagged **☐** Established **☐** Corner -Reestablished Rebuilt Identification and type of corner found: Evidence used to identify or procedure used to establish or reestablish the corner: SEE SKETCH ON BACKSIDE. A description of the physical condition of the monument as found and as set or reset:\_\_\_\_\_\_ SEE SKETCH ON BACKSIDE. SURVEYOR'S STATEMENT This Corner Record was prepared by me or under my direction in conformance with November 13 , 2012. the Land Surveyors' Act on \_\_\_\_ P.L.S. Number<u>8657</u> No. 865 COUNTY SURVEYOR'S STATEMENT This Corner Record was received NOVEMBER 13, 2012 and examined and filed Kinyary \_\_, 201**3**. R.C.E. No. <u>26994</u> Title County Surveyor County Surveyor's Comment\_\_\_\_\_ No. 26994 (D.D. Sheet No. 67 )

(Job No.



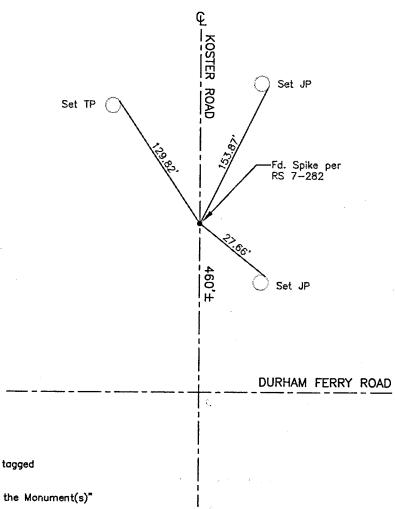

Note: Found Monuments are not tagged unless otherwise noted.

"No Attempt Was Made to Verify the Monument(s)"

Set=Conc. Nail with Brass Washer Stamped
"S.J. Co.", unless otherwise noted
Fd.=Found Conc. Nail with Brass Washer Stamped
"S.J. Co.", unless otherwise noted
CR=Corner Record
FP=Fence Post
JP=Joint Pole
LP=Light Pole
PP=Power Pole
GP=Guy Pole
SP=Service Pole
IP=Telephone Pole
S.F.N.=Searched Found Nothing
N.T.S.=Not To Scale
M&P=Maps & Plats
PM=Parcel Map
RS=Record of Survey
FB=Field Book FB=Field Book