


CORNER RECORD

City of STOCKTON

Document Number CR-13-01

County of SAN JOAQUIN, California

Brief Legal Description NORTHEAST CORNER PARCEL "A", PARCEL MAP BOOK 9, PAGE 132

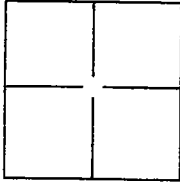

CORNER TYPE

Government Corner ☐ Control ☐
Meander ☐ Property ☒
Rancho ☐ Other ☐

Date of Survey December 20, 2012

COORDINATES(Optional)

N. _____
E. _____
Zone _____ NAD27 ☐ NAD83 ☐
NAD83 Epoch _____
Elev. _____
Vert. Datum: NGVD29 ☐ NADV88 ☐
Meas. Units: Metric ☐ Imperial ☒

Corner - Left as found ☒ Found and tagged ☐ Established ☐ Reestablished ☒ Rebuilt ☐

Identification and type of corner found: Evidence used to identify or procedure used to establish or reestablish the corner:


FOUND CHISELED CROSS PER P.M. 9-132. NORTHEAST CORNER PARCEL "A".

A description of the physical condition of the monument as found and as set or reset: FOUND AS NOTED PER P.M. 9-132
MONUMENT DESTROYED WITH CONSTRUCTION OF NEW IMPROVEMENTS FOR THE CITY OF STOCKTON
FILLMORE SCHOOL SAFE ROUTE TO SCHOOL PROJECT. CORNER REESTABLISHED AFTER CONSTRUCTION

SURVEYOR'S STATEMENT

This Corner Record was prepared by me or under my direction in conformance with
the Land Surveyor's Act on DECEMBER 20, 2012.

Signed [Signature] P.L.S. or R.C.E. No.: L.S. 7600

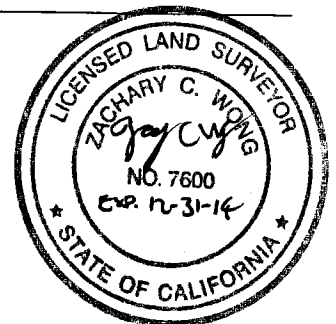

COUNTY SURVEYOR'S STATEMENT


This Corner Record was received DECEMBER 21, 2012 and examined

and filed January 26, 2013.

Signed [Signature] P.L.S. or R.C.E. No.: 26994

Title COUNTY SURVEYOR

County Surveyor's Comment _____

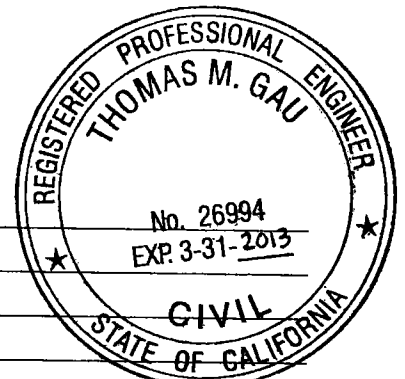



WONG ENGINEERS, INC.

PLANNING ENGINEERING SURVEYING
4578 FEATHER RIVER DRIVE, SUITE A
STOCKTON, CALIFORNIA 95219
(209) 476-0011

DESCRIPTION:

THIS DOCUMENT IS FOR THE PURPOSE OF
REESTABLISHING THE NORTHEAST CORNER
OF PARCEL "A" AS SHOWN ON PARCEL
MAP BOOK 9, PAGE 132 SAN JOAQUIN
COUNTY RECORDS.

REFERENCES:

- (A) M&P 39-39
- (B) P.M. 9-132

LEGEND:

L.S.	DENOTES LICENSED SURVEYOR
I. PIN	DENOTES IRON PIN
FD.	DENOTES FOUND
P.M.	DENOTES PARCEL MAP
MON.	DENOTES MONUMENT
O	DENOTES SET NAIL AND TAG, L.S. 7600
M&P	DENOTES MAPS AND PLATS

