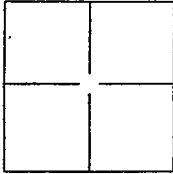


CORNER RECORD

Document Number CR-13-02

City of _____

County of San Joaquin, CaliforniaBrief Legal Description Retracement survey of the north line of R.S. 10-162, S.J.C.R.**CORNER TYPE**

Government Corner	☐	Control	☐
Meander	☐	Property	☒
Rancho	☐	Other	☐

Date of Survey September 14, 2012**COORDINATES(Optional)**

N.	<u>N/A</u>		
E.	<u>N/A</u>		
Zone	<u>N/A</u>	NAD27 ☐	NAD83 ☐
NAD83 Epoch	<u>N/A</u>		
Elev.	<u>N/A</u>		
Vert. Datum:	NGVD29 ☐	NADV88 ☐	
Meas. Units:	Metric ☐	Imperial ☒	

Corner - Left as found ☒ Found and tagged ☐ Established ☒ Reestablished ☐ Rebuilt ☐Identification and type of corner found: Evidence used to identify or procedure used to establish or reestablish the corner:
SEE SKETCH ON BACKSIDE


A description of the physical condition of the monument as found and as set or reset: _____


FOUND MONUMENTS IN GOOD CONDITION AND SET MONUMENTS AS SHOWN PER SKETCH ON BACKSIDE

(DD Sheet No. 23)

SURVEYOR'S STATEMENTThis Corner Record was prepared by me or under my direction in conformance with
the Land Surveyor's Act on September 28, 2012.Signed Walter John Shoup P.L.S. or R.C.E. No.: 7736**COUNTY SURVEYOR'S STATEMENT**This Corner Record was received JANUARY 7, 2013 and examinedand filed January 26, 2013Signed Thomas M. Gau P.L.S. or R.C.E. No.: 26994Title COUNTY SURVEYOR

County Surveyor's Comment _____

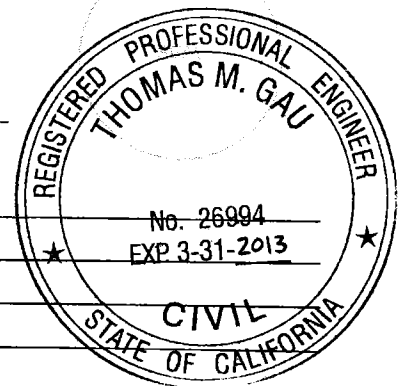

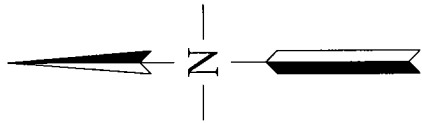


SCALE: 1"=200'



LEGEND:

- SET 3/4"x30" REBAR WITH CAP "LS 7736"
- FD. MONUMENT AS NOTED
- (R1) R.S. 10-162
- (R2) R.S. 12-153
- (R3) I.N. 86095482
- (R4) D.N. 2008-010143
- I.N. RECORDER'S INSTRUMENT NO., S.J.C.R.
- D.N. RECORDER'S DOCUMENT NO., S.J.C.R.
- R.S. RECORD OF SURVEY, BOOK-PAGE, S.J.C.R.
- S.J.C.S. SAN JOAQUIN COUNTY SURVEYOR'S
- S.J.C.R. SAN JOAQUIN COUNTY RECORDS

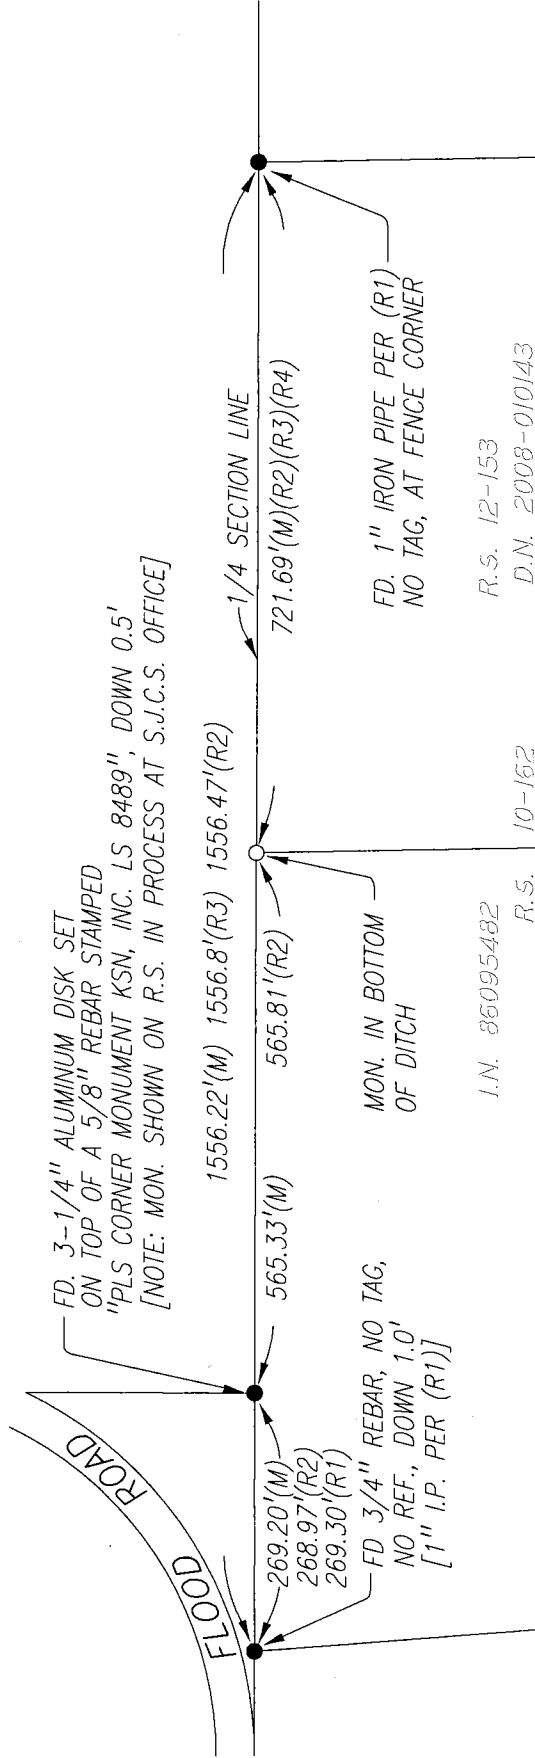

I.N. 86095482 R.S. 10-162
R.S. 12-153 D.N. 2008-010143

DD SHEET #23	SHOUP LAND SURVEYING		Date: 01/07/13
	Scale: 1"=200'	Job No.: 12-023	DWG: 12023CR.DWG