

# CORNER RECORD

Document Number CR-13-07City of LATHROPCounty of SAN JOAQUIN, CaliforniaBrief Legal Description SURVEY MONUMENT AT THE INTERSECTION OF LATHROP ROAD AND MANTHEY ROAD  
LOCATED IN THE SOUTHEAST QUARTER OF SECTION 22, T.1S., R.6E., M.D.B.&M.

NW 1/4	NE 1/4
SW 1/4	SE 1/4

SEC.22 T.1S, R.6E

## CORNER TYPE

Government Corner ☐ Control ☐  
Meander ☐ Property ☐  
Rancho ☐ Other ☒Date of Survey 01-10-2013

## COORDINATES (Optional)

N \_\_\_\_\_  
E \_\_\_\_\_  
Zone \_\_\_\_\_ NAD27 ☐ NAD83 ☐  
NAD83 Epoch \_\_\_\_\_  
Elev. \_\_\_\_\_  
Vert. Datum: NVGD29 ☐ NVGD88 ☐  
Meas. Units: Metric ☐ Imperial ☒Corner— Left as found ☐ Found and tagged ☐ Established ☐ Reestablished ☒ Rebuilt ☐Identification and type of corner found: Evidence used to identify or procedure used to establish or reestablish the corner:  
SET 3/4" IRON PIPE WITH PLASTIC PLUG, STAMPED L.S. 6953 AT THE APPROXIMATE INTERSECTION OF  
LATHROP ROAD AND MANTHEY ROAD LOCATED IN THE SOUTHEAST QUARTER OF SECTION 22, T.1S., R.6E.,  
M.D.B.&M. MONUMENT WAS DESTROYED DURING CONSTRUCTION. FOUND WITNESS CORNERS AS SHOWN ON  
CORNER RECORD DOCUMENT NUMBER 12-444 SAN JOAQUIN COUNTY SURVEYOR RECORDS.

A description of the physical condition of the monument as found and as set or reset: \_\_\_\_\_

SET 3/4" IRON PIPE WITH PLASTIC PLUG STAMPED L.S. 6953 FROM TIES AS SHOWN ON PAGE 2.


## SURVEYOR'S STATEMENT

This Corner Record was prepared by me or under my direction in conformance with  
the Land Surveyors' Act on JANUARY 14, 2013,Signed [Signature] P.L.S. or R.C.E. Number 6953

## COUNTY SURVEYOR'S STATEMENT

This Corner Record was received JANUARY 17, 2013 and examinedand filed February 12, 2013Signed [Signature] P.L.S. or R.C.E. No: 26994Title COUNTY SURVEYOR

County Surveyor's Comment \_\_\_\_\_

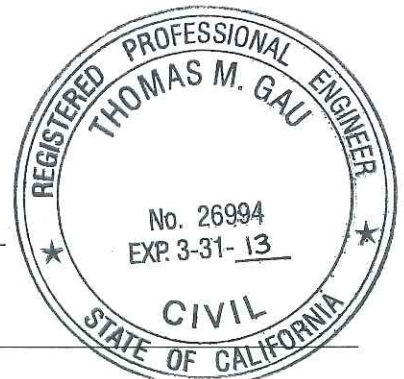

FOUND CONCRETE NAIL WITH  
BRASS TAG LS 6953.(R1)

FOUND CONCRETE NAIL WITH  
BRASS TAG LS 6953.(R1)

LATHROP ROAD

SET 3/4" IRON PIPE WITH  
PLASTIC PLUG, STAMPED  
L.S. 6953 FLUSH WITH  
PAVEMENT.(R1)

### LEGEND:



SET MONUMENT AS NOTED



FOUND MONUMENT AS NOTED.

S.J.C.S.R. DENOTES SAN JOAQUIN CO. SURVEYOR RECORDS

C.R. DENOTES CORNER RECORD, S.J.C.S.R.

(M) MEASURED DISTANCE. ALL DISTANCES ARE

MEASURED UNLESS NOTED OTHERWISE.



NOT TO SCALE

### REFERENCES:

(R1) C.R. 12-444, S.J.C.S.R.

114°20'42"

MANTHEY ROAD

234.94'(M)

FOUND PIN & WASHER  
IN PAVEMENT.