
STATE OF CALIFORNIA • DEPARTMENT OF TRANSPORTATION CORNER RECORD Document Number CR-13-50 DPD-3011 (Rev. 9/97) CT# 7541-4548-0 County of San Joaquin City of Brief Legal Description Monuments referencing original locations of N.W. cor. Lot 4 & N.E. cor. Lot 5, Sunny Slope Farms **CORNER TYPE COORDINATES (Optional)** Government Corner Control Meander Property Zone Other NAD83 Epoch Rancho Elevation Feb. 2010 Date of Survey SEC. L. Vert. Datum: NGVD29 NAVD88 \boxtimes C.M. WEBER GRANT Meas. Units: Metric Imperial Corner -Left as found Found and tagged Established Reestablished Rebuilt Identification and type of corner found: Evidence used to identify or procedure used to establish or reestablish the corner: See reverse side A description of the physical condition of the monument as found and as set or reset: See reverse side SURVEYOR'S STATEMENT This Corner Record was prepared by me or under my direction in conformance with the Land Surveyors' Act on February 21 , 2013 Exp. 9 - 30 P.L.S. or R.C.E. Number PLS 6948 Signed Klimet For the State of California OF CALL Department of Transportation COUNTY SURVEYOR'S STATEMENT OMAS M. G This Corner Record was received March and examined P.L.S. of R.C.E. Number 26994 No. 26994 EXP. 3-31-2015 Title COUNTY SURVEYOR County Surveyor's Comment This corner record is not in compliance with Board Rule 464(c) regarding

Page 1 of 2

days of the date of survey.

CORNER RECORD

02-DPD-3011A (NEW 06/2010)

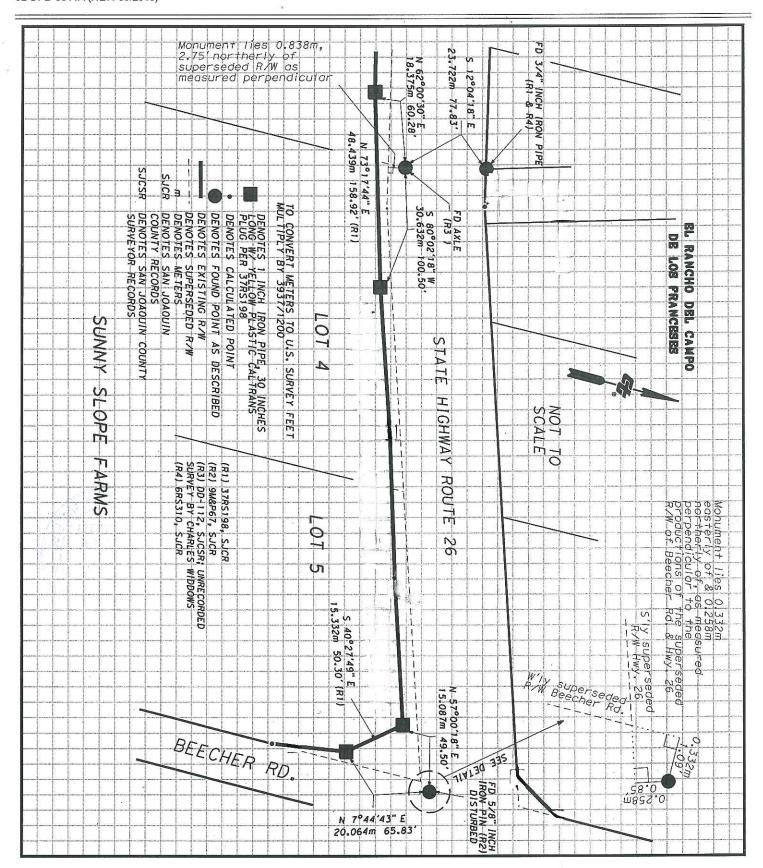

Page 2 of 2