


CORNER RECORD

Document Number CR-13-93

City of _____

County of San Joaquin, California

Brief Legal Description Monuments in Section 25, T4N, R7E, MDB&M

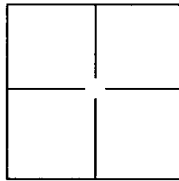

CORNER TYPE

Government Corner ☐ Control ☐
Meander ☐ Property ☒
Rancho ☐ Other ☒

Date of Survey September 3, 2012

COORDINATES(Optional)

N. _____
E. _____
Zone 3 NAD27 ☐ NAD83 ☒
NAD83 Epoch _____
Elev. _____
Vert. Datum: NGVD29 ☐ NADV88 ☐
Meas. Units: Metric ☐ Imperial ☒

Corner - Left as found ☒ Found and tagged ☐ Established ☐ Reestablished ☐ Rebuilt ☐

Identification and type of corner found: Evidence used to identify or procedure used to establish or reestablish the corner:

Multiple monuments on the centerline of Elliot Road were found and surveyed. This work was done by CLSA

Central Valley Chapter volunteers as part of an effort to preserve property corner monuments during San

Joaquin County summer chip seal projects. The coordinates shown on this corner record are based on the

California Central Valley Control Network, Epoch Date 2012-09-23, Version 1.01. A copy of the control survey

is available from KSN in digital form upon request.

A description of the physical condition of the monument as found and as set or reset: See the back of this corner record for a

description of found property corner monuments and monuments set as local survey control. Monument photos and

field notes are available in digital form from KSN or the CLSA California Central Valley Chapter. The combined

scale factor for the coordinates shown is 0.9999566665. The mapping angle is -00-24-07. Both the combined

scale factor and the mapping angle were calculated at Point #1201.

SURVEYOR'S STATEMENT

This Corner Record was prepared by me or under my direction in conformance with

the Land Surveyor's Act on February 1, 2013.

Signed [Signature] P.L.S. or R.C.E. No.: PLS 8489



COUNTY SURVEYOR'S STATEMENT

This Corner Record was received APRIL 8, 2013 and examined

and filed MAY 12, 2013.

Signed Thomas M. Gau P.L.S. or R.C.E. No.: 26994

Title COUNTY SURVEYOR

County Surveyor's Comment _____



MONUMENT LIST

POINT NUMBER: 319
DESCRIPTION: FOUND BOLT AND WASHER IN MON WELL.
NORTHING: 2249653.42 EASTING: 6371651.05

POINT NUMBER: 321
DESCRIPTION: FOUND BOLT AND WASHER IN MONUMENT WELL.
NORTHING: 2249059.94 EASTING: 6372053.68

POINT NUMBER: 320
DESCRIPTION: FOUND BOLT AND WASHER IN MONUMENT WELL.
NORTHING: 2248970.46 EASTING: 6372084.07

POINT NUMBER: 606
DESCRIPTION: FOUND BOLT & WASHER IN MON WELL.
NORTHING: 2248551.39 EASTING: 6372436.67


POINT NUMBER: 310
DESCRIPTION: FOUND 1" DIAMETER METAL ROD IN MON WELL.
NORTHING: 2248365.49 EASTING: 6372779.92

POINT NUMBER: 309
DESCRIPTION: FOUND 1" DIAMETER METAL ROD IN MON WELL.
NORTHING: 2248263.99 EASTING: 6372940.22

POINT NUMBER: 1201
DESCRIPTION: SET MAG NAIL AND SHINER AS CONTROL POINT STAMPED "PLS 8489".
NORTHING: 2248289.19 EASTING: 6372938.87

POINT NUMBER: 308
DESCRIPTION: FOUND 1" DIAMETER METAL ROD IN MON WELL.
NORTHING: 2247901.01 EASTING: 6373435.07

POINT NUMBER: 307
DESCRIPTION: FOUND 1" DIAMETER METAL ROD IN MON WELL.
NORTHING: 2247547.18 EASTING: 6373889.49

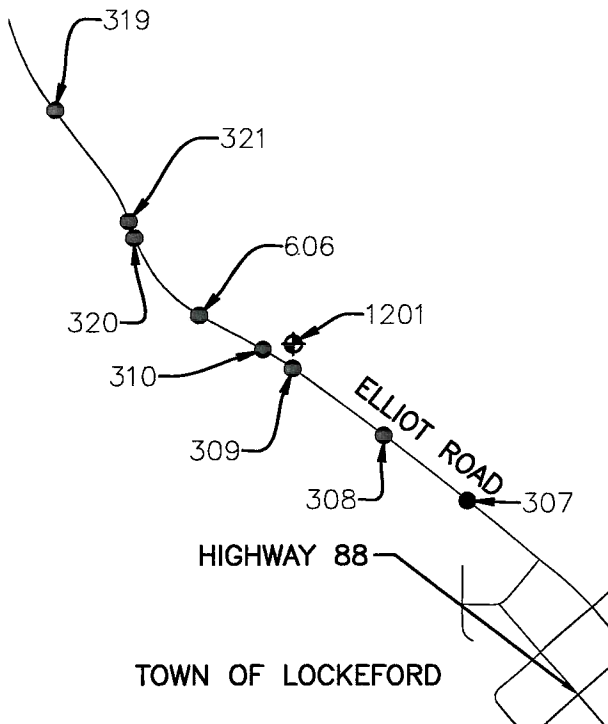

THE CLSA CENTRAL VALLEY CHAPTER
SAN JOAQUIN COUNTY GOVERNMENT
LIAISON COMMITTEE WOULD LIKE TO
THANK GEORGE BALL, CHRIS MARTIN,
ALFREDO MIJANGO, AND JULIAN
PADILLA FOR THEIR VOLUNTEER
WORK ON THIS PROJECT. THEY
WOULD LIKE TO THANK KSN FOR
PROVIDING FUEL, SUPPLIES AND
EQUIPMENT FOR THE PROJECT.

UNITS SHOWN ARE US SURVEY FEET.

**KJELDSSEN
SINNOCK
NEUDECK**
INC.
Civil Engineers
and Land Surveyors

711 N. Pershing Avenue
Stockton, CA 95203-2152
Office: (209) 946-0268
Fax: (209) 946-0296
E-mail: KSN@ksninc.com

CLSA CENTRAL VALLEY CHAPTER
SUMMER 2012 SAN JOAQUIN COUNTY
**CHIP SEAL PROJECTS
CORNER RECORD**

Design
SLB
Drawn
SLB
Check
BAS

Scale
1"=1000'
Original Drawing Scale
0 1/4" 1/2"

Date
JANUARY 2013
Sheet Number
2 Of 2
Project File No.