


CORNER RECORD

Document Number CR-13-99

City of Manteca

County of San Joaquin, California

Brief Legal Description E. 1/2 of SW 1/4 of SE 1/4 of Sec. 29, T.1S., R.7E., M.D.B. & M., Louise Manor Unit 4, M.&P.19-18, S.J.C.R., Centerline EC Yvonne Ave. North of Diane Dr., Manteca

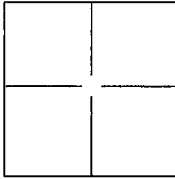

CORNER TYPE

Government Corner ☐ Control ☐
Meander ☐ Property ☐
Rancho ☐ Other ☒

Date of Survey August 11, 2012

COORDINATES(Optional)

N. _____
E. _____
Zone _____ NAD27 ☐ NAD83 ☐
NAD83 Epoch _____
Elev. _____
Vert. Datum: NGVD29 ☐ NADV88 ☐
Meas. Units: Metric ☐ Imperial ☒

Corner - Left as found ☒ Found and tagged ☐ Established ☐ Reestablished ☐ Rebuilt ☐

Identification and type of corner found: Evidence used to identify or procedure used to establish or reestablish the corner:

Fd. 3/4" Iron Pipe, called 1" Iron Pipe tagged R.C.E. 5905 per M.&P. 19-18, S.J.C.R. at EC of Yvonne Avenue North of Diane Drive.

A description of the physical condition of the monument as found and as set or reset: _____

Set plastic cap stamped L.S. 4450 and set two 2.00 feet 1-1/4" Mag Nail reference points as shown on page 2.

SURVEYOR'S STATEMENT

This Corner Record was prepared by me or under my direction in conformance with

the Land Surveyor's Act on February 7, 2013

Signed Michael L. Quatara P.L.S. or R.C.E. No.: L.S. 4450



COUNTY SURVEYOR'S STATEMENT


This Corner Record was received February 19, 2013 and examined

and filed MAY 12 2013


Signed Thomas M. Gau P.L.S. or R.C.E. No.: 26994

Title COUNTY SURVEYOR

County Surveyor's Comment _____

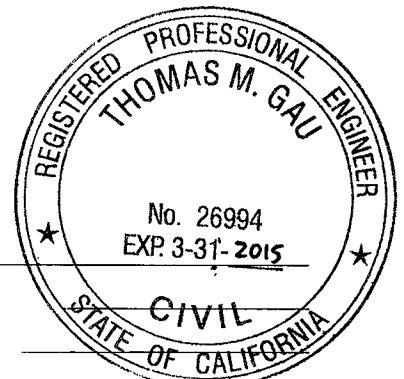

PRE-CONSTRUCTION CORNER RECORD

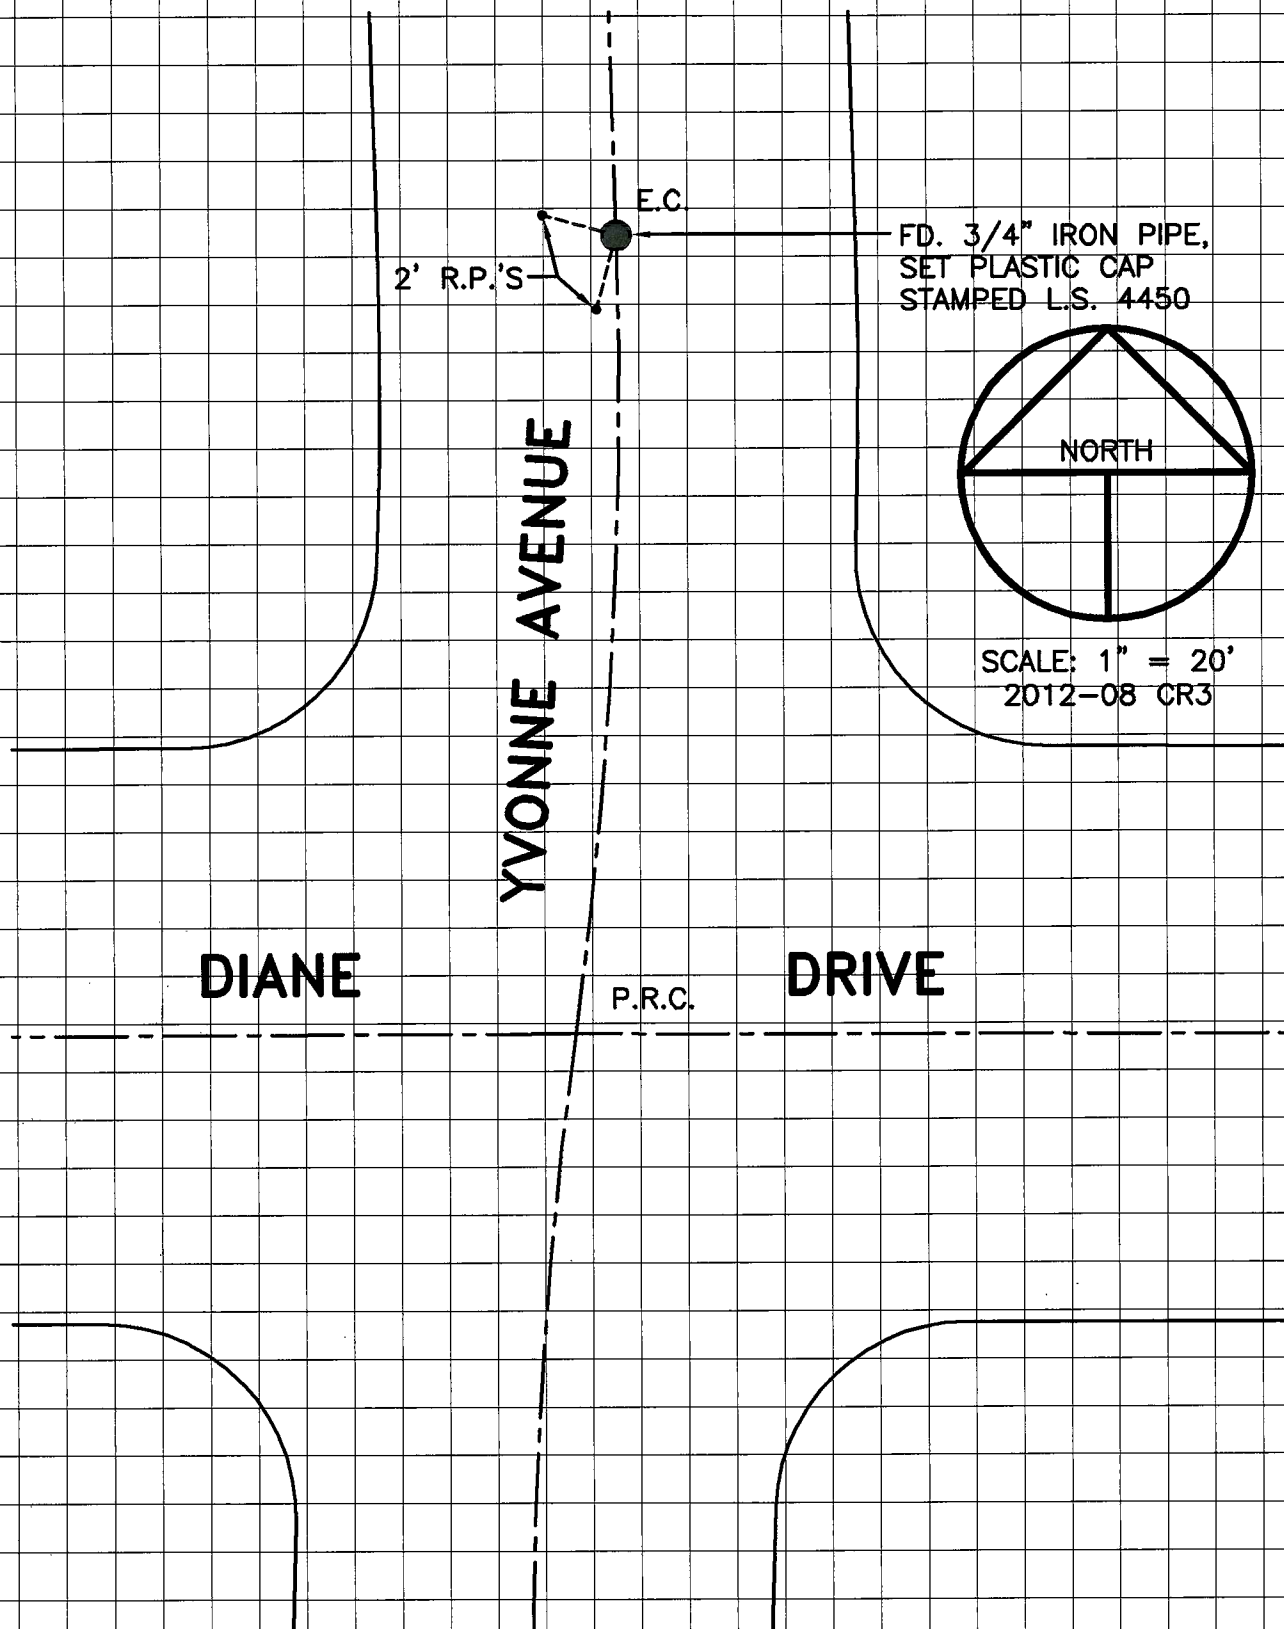

NO ATTEMPT WAS MADE TO VERIFY THE
POSITION OF THE MONUMENT