
CORNER RECORD Document Number _ CR-13-106 California City of _____ County of San Joaquin, Brief Legal Description ____DUSTIN ROAD - 1,838' ± NORTH OF PELTIER ROAD (ON SECTION 17 EAST LINE, TOWNSHIP 4 NORTH, RANGE 7 EAST, MOUNT DIABLO BASE & MERIDIAN) **CORNER TYPE** COORDINATES (Optional) Government Corner Control NAD27 ☐ NAD83 ☐ Meander Property NAD83 Epoch___ Rancho Other Elev. Vert. Datum: NGVD29 □ NAVD88 Date of Survey ____April 22, 2013 Meas. Units: Metric Imperial 🗵 Left as found ☐ Found and tagged ☐ Established ☐ Corner -Reestablished Rebuilt Identification and type of corner found: Evidence used to identify or procedure used to establish or reestablish the corner: SEE SKETCH ON BACKSIDE. A description of the physical condition of the monument as found and as set or reset: SEE SKETCH ON BACKSIDE. SURVEYOR'S STATEMENT This Corner Record was prepared by me or under my direction in conformance with the Land Surveyors' Act on April 29 Signed James & Hat P.L.S. Number 8657 LICENSE No. 865 COUNTY SURVEYOR'S STATEMENT This Corner Record was received April 30, 2013 and examined MAY 12 and filed , 2013, R.C.E. No. 26994 Signed Title County Surveyor County Surveyor's Comment_____ No. 26994 (D.D. Sheet No. 11)

(Job No. 220081)

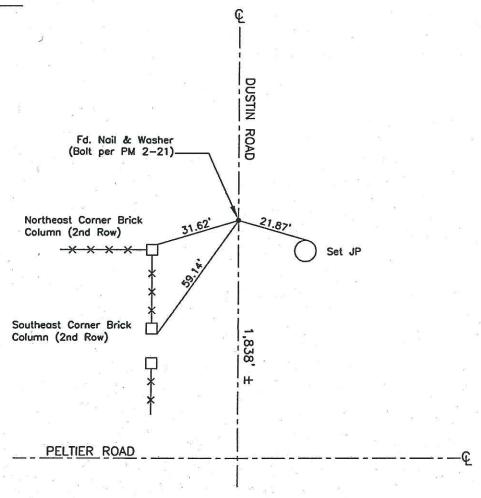

N.T.S.



Note: Found Monuments are not tagged unless otherwise noted.

"No Attempt Was Made to Verify the Monument(s)"

Set=Conc. Nail with Brass Washer Stamped
"S.J. Co.", unless otherwise noted
Fd.=Found Conc. Nail with Brass Washer Stamped
"S.J. Co.", unless otherwise noted
CR=Corner Record
FP=Fence Post
JP=Joint Pole
LP=Light Pole
PP=Power Pole
GP=Guy Pole
SP=Service Pole
IP=Telephone Pole
S.F.N.=Searched Found Nothing
N.T.S.=Not To Scale
M&P=Maps & Plats
PM=Porcel Map
RS=Record of Survey
FB=Field Book

FB=Field Book