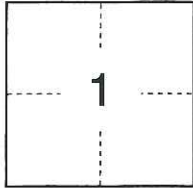


CORNER RECORDCity of LodiDocument Number CR-13-148
County of San Joaquin, CaliforniaBrief Legal Description Hutchins Street in Section 1, T.3N, R.6E, M.D.B.&M.**CORNER TYPE**Government Corner ☐ Control ☐
Meander ☐ Property ☐
Rancho ☐ Other ☒Date of Survey April 16, 2013**COORDINATES (Optional)**N. _____
E. _____
Zone _____ NAD27 ☐ NAD83 ☐
NAD83 Epoch _____
Elev. _____
Vert. Datum: NGVD29 ☐ NAVD88 ☐
Meas. Units: Metric ☐ Imperial ☒Corner - Left as found ☐ Found and tagged ☐ Established ☐ Reestablished ☒ Rebuilt ☐Identification and type of corner found: Evidence used to identify or procedure used to establish or reestablish the corner:
It is the purpose of this corner record to reestablish monuments shown on Corner Record 13-51.

A description of the physical condition of the monument as found and as set or reset:

Monuments reset with 1.25" diameter brass disk stamped "LS 7889" in concrete sidewalk.


SURVEYOR'S STATEMENTThis Corner Record was prepared by me or under my direction in conformance with
the Land Surveyors' Act on May 3, 2013.Signed [Signature] (L.S. or R.C.E. Number 7889)**COUNTY SURVEYOR'S STATEMENT**This Corner Record was received May 10, 2013, and examined
and filed May 15, 2013.Signed [Signature: Thomas M. Gau] R.C.E. No. 26994Title County Surveyor

County Surveyor's Comment _____

(D.D. Sheet No. 15B)

APN: 037-310-39
241 S. HUTCHINS ST.
LOT 6
M & P G-27

APN: 037-310-40
235 S. HUTCHINS ST.
LOT 5
M & P G-27

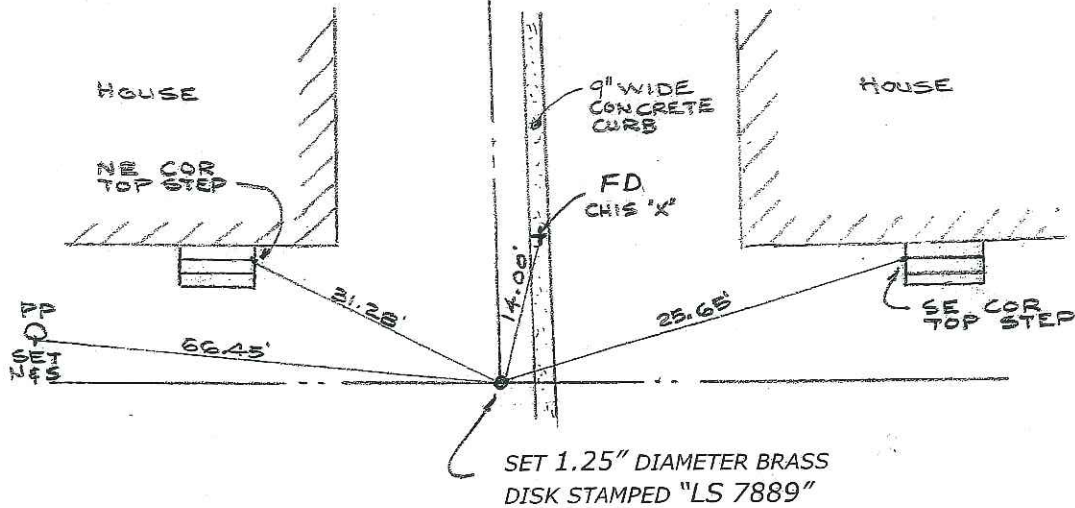


HUTCHINS STREET



APN: 037-310-41
215 S. HUTCHINS ST.
LOT 4
M & P G-27

APN: 037-310-42
211 S. HUTCHINS ST.
LOT 3
M & P G-27

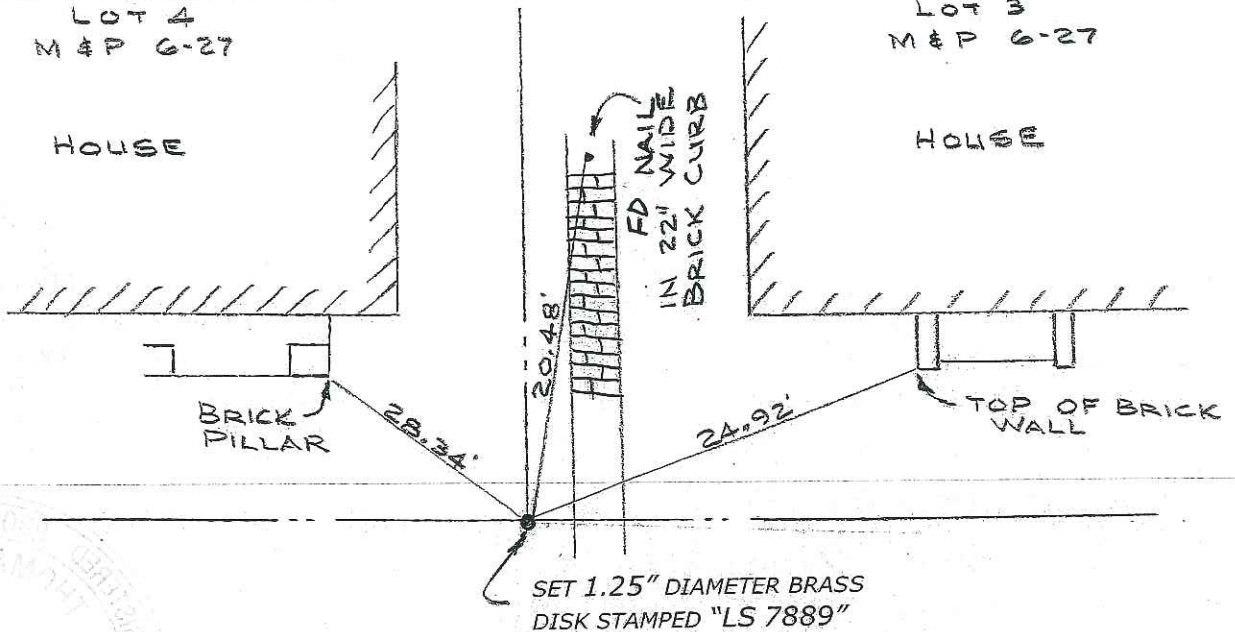

HUTCHINS STREET

