

CORNER RECORD Document Number CR-13-159

City of STO	CKTON		ocument is	SAN JOA	OUIN	, California
Brief Legal Description	LOTS 1432-	 1433 OF M&	P 31-104			_, очионич
	Government Corner Meander Rancho	R TYPE Control Property Other		N E Zone	NAD27	
	Date of Survey JANU	ARY 2, 2013	-	Elev. Vert, Datum: Meas, Units;	NGVD29	NADV88
Corner - Left as found	Found and tag	iged 📗 Est	ablished	Reestab	lished 🗹	Rebuilt 🔲
(I.N. 931) A description of the physical co	LISHED CENTERLINE 32076) AS PER R.O. ondition of the monument ' - 24" LONG REBAR	S. 34-33. as found and as	set or reset:			
This Corner Record was prethe Land Surveyor's Act on Signed	MARCH 28	my direction in 201		e with	SONAL No. * EXP S	LAND OF BEAL SEAL ALIFORNIA
This Corner Record was received and filed Signed Signed	March 2 S , 2013 Veyor	% , 2.0 3			REGISTION NOW THE PROPERTY OF	OFESSIONAL AS M. GALL 10. 26994 2.3-31-2015

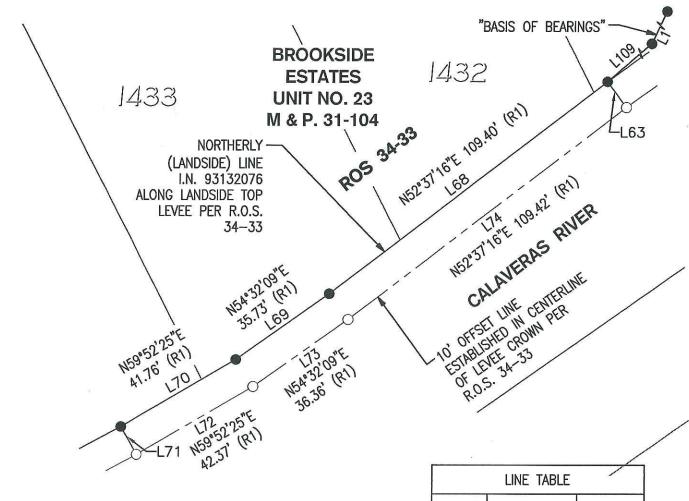

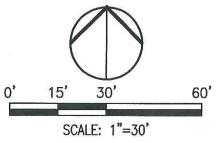



LINE TABLE				
LINE #	DIRECTION	LENGTH		
L1	N25°49'03"E	70.76		
L63	S36°36'34"E	10.00'		
L68	N52°38'18"E	109.47'		
L69	S54°37'08"W	35.66'		
L70	N59°46'36"E	41.67'		
L71	S29°21'25"E	10.00'		
L72	N59°46'36"E	42.27'		
L73	S54°37'08"W	36.28'		
L74	N52°38'18"E	109.52'		
L109	S49°20'21"W	2979.37		

LEGEND:

M.&P. BOOK OF MAPS & PLATS , BOOK-PAGE

ROS RECORD OF SURVEY, BOOK-PAGE

FOUND 3/4" REBAR W/CAP ATTACHED AND STAMPED "LS 4334" PER R.O.S. 34—33

O SET 3/4" REBAR, 24" LONG, W/CAP ATTACHED AND STAMPED "LS 8247"

BASIS OF BEARINGS:

THE NORTHERLY LANDSIDE LINE (L1), BEING LINE L199 PER R.O.S. 34-33, WHICH BEARS N25°49'03"E.

NOTE: ALL BEARINGS AND DISTANCES BETWEEN MONUMENTS ARE MEASURED VALUES.

(R1) R.O.S. 34-33, S.J.C.R.