


CORNER RECORD

Document Number CR-13-164
County of SAN JOAQUIN, California

City of _____

Brief Legal Description REMAINDER PARCEL OF P.M. 16-60 IN SEC. 31, T.4N., R.8E., M.D.B.&M.

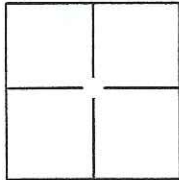

CORNER TYPE

Government Corner ☐ Control ☐
Meander ☐ Property ☒
Rancho ☐ Other ☐

Date of Survey May 25, 2013

COORDINATES(Optional)

N. _____
E. _____
Zone _____ NAD27 ☐ NAD83 ☐
NAD83 Epoch _____
Elev. _____
Vert. Datum: NGVD29 ☐ NADV88 ☐
Meas. Units: Metric ☐ Imperial ☒

Corner - Left as found ☐ Found and tagged ☐ Established ☐ Reestablished ☒ Rebuilt ☐


Identification and type of corner found: Evidence used to identify or procedure used to establish or reestablish the corner:
SEARCHED FOUND NOTHING. SET SURVEY MONUMENT BY USING FOUND MONUMENTS AS SHOWN ON
PARCEL MAP, BOOK 16, PAGE 60. SEE ATTACHED PLAT.

A description of the physical condition of the monument as found and as set or reset: SEARCHED FOUND NOTHING, SET
WITH A 3/4" IRON PIN CAPPED L.S. 7600 AND NAIL AND BRASS TAG L.S. 7600.

SURVEYOR'S STATEMENT

This Corner Record was prepared by me or under my direction in conformance with
the Land Surveyor's Act on MAY 25, 2013.

Signed [Signature] P.L.S. or R.C.E. No.: L.S. 7600

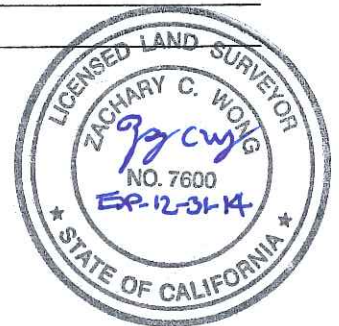

COUNTY SURVEYOR'S STATEMENT

This Corner Record was received May 25, 2013 and examined
and filed June 5, 2013.

Signed Thomas M. Gau P.L.S. or R.C.E. No.: 26994

Title County Surveyor

County Surveyor's Comment _____

