


CORNER RECORD

Document Number CR-13-209
City of _____ County of San Joaquin, California

Brief Legal Description San Francisco Water District Monument B2306+79.07

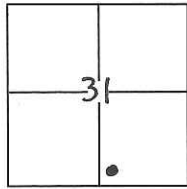

T 3 S, R 6 E, MDM

CORNER TYPE

Government Corner ☐ Control ☐
Meander ☐ Property ☐
Rancho ☐ Other ☒

Date of Survey May 20, 2013

COORDINATES(Optional)

N. _____
E. _____
Zone _____ NAD27 ☐ NAD83 ☐
NAD83 Epoch _____
Elev. _____
Vert. Datum: NGVD29 ☐ NADV88 ☐
Meas. Units: Metric ☐ Imperial ☒

Corner - Left as found ☐ Found and tagged ☐ Established ☐ Reestablished ☒ Rebuilt ☐

Identification and type of corner found: Evidence used to identify or procedure used to establish or reestablish the corner:

"B" Line monument B2306+79.07, a 3.5" brass disk set in concrete, referenced in the index entitled

"Hetch Hetchy Water & Power, Moccasin to Tesla Portal R.O.W. Survey, Final Coordinate List".

Monument verified and witness corners established prior to construction.

For survey report, contact Survey Dept., 1 Lakeshore Dr., Moccasin, CA 95347.

Reset San Francisco Water District Monument from witness corners after construction.

A description of the physical condition of the monument as found and as set or reset: _____

Set a 2' X 6" concrete cylinder 2' below grade with a 3.5" aluminum cap stamped

"City and County of San Francisco H.H.W.S. STA. B230679.07 L.S. 8755 EL. 245.90"

SURVEYOR'S STATEMENT

This Corner Record was prepared by me or under my direction in conformance with
the Land Surveyor's Act on May 20, 2013.

Signed [Signature] P.L.S. or R.C.E. No.: 8755




COUNTY SURVEYOR'S STATEMENT

This Corner Record was received June 4, 2013 and examined
and filed June 24, 2013.

Signed Thomas M. Gau P.L.S. or R.C.E. No.: 26994

Title County Surveyor

County Surveyor's Comment _____

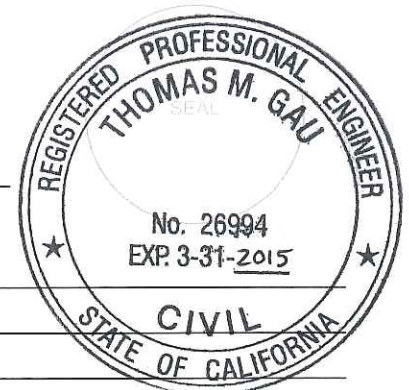

SET A 2' X 6" CONCRETE CYLINDER WITH A
3-1/2" ALUMINUM CAP STAMPED CITY AND COUNTY
OF SAN FRANCISCO H.H.W.S., STA.B230679.07
L.S. 8755 EL. 245.90'

FOUND LEAD & TACK IN
CONCRETE AT BASE
OF TOWER

FOUND LEAD & TACK IN
CONCRETE AT BASE
OF TOWER

S67°58'12"E 9.95'

S68°45'32"W 10.18'

N21°43'57"E 113.92'

SET MAG NAIL IN PAVEMENT
OF BLEWETT ROAD

0 15' 30'



1" = 30'

