


CORNER RECORD

Document Number CR-13-227

City of _____

County of San Joaquin, California

Brief Legal Description Southeasterly corner of the 10.20 Acre parcel shown on R.S. 37-33, S.J.C.R.

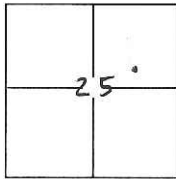

S25, T3N, R9E, MDM

CORNER TYPE

Government Corner ☐ Control ☐
Meander ☐ Property ☒
Rancho ☐ Other ☐

Date of Survey June 22, 2013

COORDINATES(Optional)

N. _____
E. _____
Zone _____ NAD27 ☐ NAD83 ☐
NAD83 Epoch _____
Elev. _____
Vert. Datum: NGVD29 ☐ NADV88 ☐
Meas. Units: Metric ☐ Imperial ☐

Corner - Left as found ☐ Found and tagged ☐ Established ☐ Reestablished ☒ Rebuilt ☐

Identification and type of corner found: Evidence used to identify or procedure used to establish or reestablish the corner:
It is the purpose of this Corner Record to replace the bent monument. No attempt was made to determine the validity of the monument or its proper location in relation to the County Line or the 1/4 Section Line.

A description of the physical condition of the monument as found and as set or reset: Replaced bent 5/8" Rebar with 3/4" Iron Pipe with plastic cap stamped L.S. 4450. (See Attached Sketch)

SURVEYOR'S STATEMENT

This Corner Record was prepared by me or under my direction in conformance with the Land Surveyor's Act on July 2, 2013.

Signed Michael L. Quarantoli P.L.S. or R.C.E. No.: L.S. 4450



COUNTY SURVEYOR'S STATEMENT

This Corner Record was received July 9, 2013 and examined and filed August 2, 2013.

Signed Thomas M. Gau P.L.S. or R.C.E. No.: 26994


Title County Surveyor

County Surveyor's Comment _____



REFERENCE

(A) R.S. 37-33, S.J.C.R.

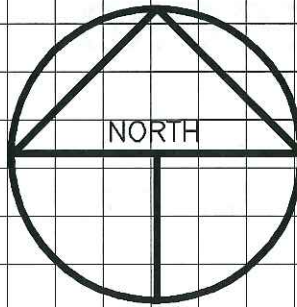

SCALE: 1" = 200'
2013-133

**WIMER
ROAD**

N00°00'36"W (A) 1001.75'(A)

FD. 5/8" REBAR
TAGGED L.S.
4222 PER (A)

10.20 ACRES
R.S. 37-33

S41°34'49"E (A)
CALAVERAS COUNTY
SAN JOAQUIN COUNTY
1194.34'(A)

COUNTY LINE PER (A)

FD. AXLE AT
CENTER OF SEC.
25 PER (A)

1/4 SECTION LINE

FD. 3/4" REBAR
TAGGED L.S. 3535
PER (A)

S41°35'10"E (A)
142.81'(A)

20' 30'

S89°54'03"W (A) 887.26'(A)
FOUND 5/8" REBAR TAGGED L.S. 4222
PER (A) TOP HALF BENT AND BOTTOM
HALF VERTICAL, REPLACED WITH 3/4"
PIPE WITH PLASTIC CAP STAMPED LS
4450

LEGEND



FD.
R.S.
S.J.C.R.

INDICATES FOUND MONUMENT AS NOTED
INDICATES SET MONUMENT AS NOTED

INDICATES FOUND ON THIS SURVEY
INDICATES RECORD OF SURVEY, BOOK AND PAGE, S.J.C.R.
INDICATES SAN JOAQUIN COUNTY RECORDS