
CORNER RECORD

		TED			own Vi	E DESCRIPTION TO SERVE	ativa make and a			1000
	INCORPORA					SAN JO				, California
Brief Legal D	escription _	A PORTION	OF THE NE	1/4, SE	ECTION 8, T	3S, R6E, M	IDM.			
		,	CORNER T	YPE			COORDI	NATE	S(Opt	ional)
8 .	•	Government Con Meander Rancho	ner 🔲	Control Property Other		E Zone	poch		NAD27	
8, T35, R6E,	,MDM	Date of Survey	June 17, 2	2013		Elev. Vert. Dat Meas. U	um: NG	SVD29		NADV88 Imperial
Corner -	Left as found	☐ Fou	nd and tagged		Established [F	teestablished	×	Re	ebuilt 🔲
FOUND IRON (SEE SKETC)	to the saw to be a second	BOLT & WASHE	ER MONUM	ENTS F	PER RECOR	RD OF SUF	VEY, BK.	19, P	G. 78	
		ENTS PER RS 27" AT TWO O					2)			2
		SLIDVEVOE						-	and the party of the last of t	The state of the s
		SURVETOR	S STATEME	ENT			/	CED	LAN	Day
the Land Survey		pared by me of		direction	013		TOOM the	NO EXP	LAN K. S. LS	6627 51 (2013
This Corner Re	yor's Act on	pared by me o	r under my _P.L.S. or R.	direction , <u>2</u> .C.E. No.	013 . .: LS 66		(2017 th 3)	NO EXP	s. LS 12/3	

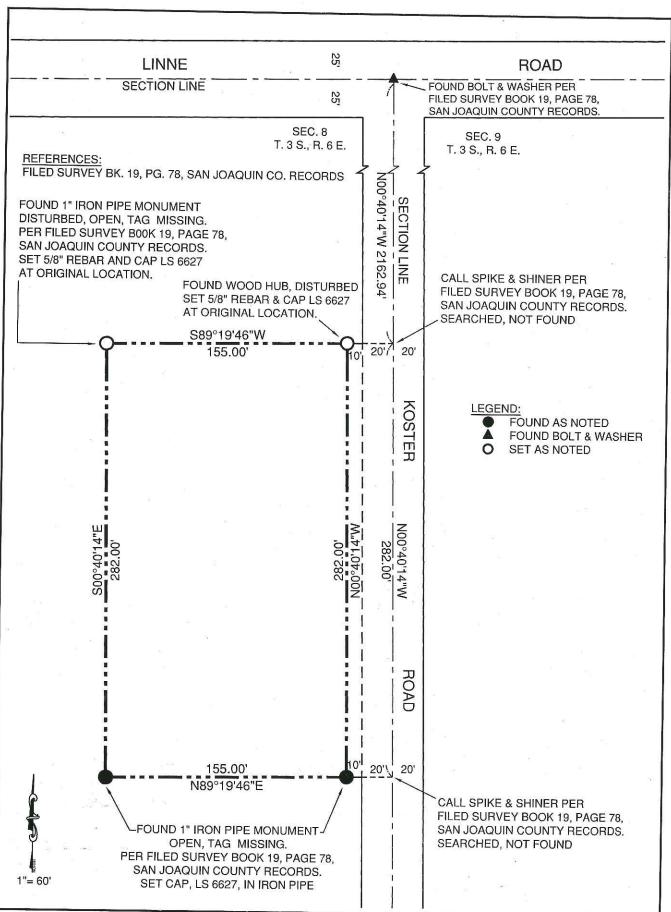

Page 2 of 2