STATE OF CALIFORNIA • DEPARTMENT OF TRANSPORTATION CORNER RECORD Document Number CR-13-25H DPD-3011 (Rev. 9/97) CT# 7541-4548-0 County of San Joaquin , California City of _____ Brief Legal Description S.W. & N.W. corners as described in Doc. # 2005-297917 San Joaquin County Records CORNER TYPE COORDINATES (Optional) Government Corner Control Property Meander Zone Rancho Other NAD83 Epoch Elevation 04/11/2013 Date of Survey T3N, R4E, MDM Vert. Datum: NGVD29 NAVD88 Meas, Units: Metric Imperial Left as found Found and tagged Established Reestablished Rebuilt Corner -Identification and type of corner found: Evidence used to identify or procedure used to establish or reestablish the corner: See Reverse Side A description of the physical condition of the monument as found and as set or reset: See Reverse Side SURVEYOR'S STATEMENT This Corner Record was prepared by me or under my direction in conformance with the Land Surveyors' Act on June 18 , 2013 P.L.S. or R.C.E. Number P.L.S. 6948 Signed / HMM For the State of California Department of Transportation COUNTY SURVEYOR'S STATEMENT MOMAS M This Corner Record was received July 23 , 2013 and examined SEAL MULPLS or R.C.E. Number 26994 No. 26994

Page 1 of 2


Title County Surveyor

County Surveyor's Comment

EXP 3-31-2015

CORNER RECORD

02-DPD-3011A (NEW 06/2010)

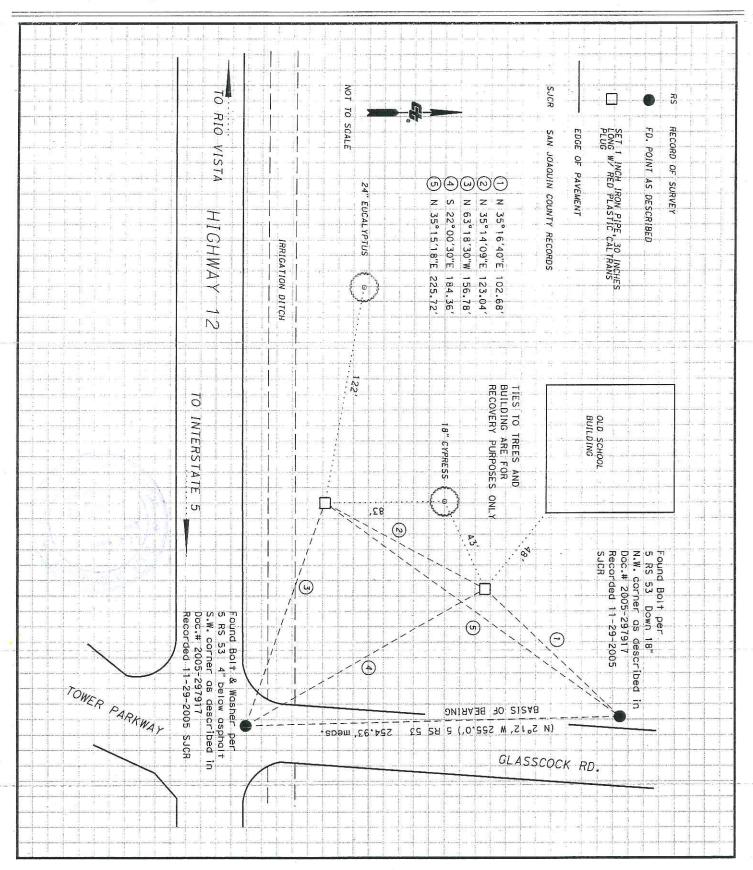

Page 2 of 2