


# CORNER RECORD

Document Number CR-13-255  
City of Stockton County of San Joaquin, California

Brief Legal Description Lot 6, Per M. & P. 10-115, S.J.C.R.

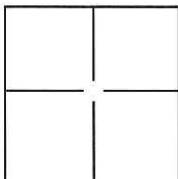

## CORNER TYPE

Government Corner ☐ Control ☐  
Meander ☐ Property ☒  
Rancho ☐ Other ☐

Date of Survey June 15, 2013

## COORDINATES(Optional)

N. \_\_\_\_\_  
E. \_\_\_\_\_  
Zone \_\_\_\_\_ NAD27 ☐ NAD83 ☐  
NAD83 Epoch \_\_\_\_\_  
Elev. \_\_\_\_\_  
Vert. Datum: NGVD29 ☐ NADV88 ☐  
Meas. Units: Metric ☐ Imperial ☐

Corner - Left as found ☒ Found and tagged ☐ Established ☐ Reestablished ☐ Rebuilt ☐

Identification and type of corner found: Evidence used to identify or procedure used to establish or reestablish the corner:  
Found Chiseled Crosses and Chiseled Cuts as shown on attached Sketch.

A description of the physical condition of the monument as found and as set or reset: Found Chiseled Crosses and Chiseled Cuts as shown on attached Sketch.

## SURVEYOR'S STATEMENT

This Corner Record was prepared by me or under my direction in conformance with  
the Land Surveyor's Act on July 16, 2013.

Signed Michael L. Quaratori P.L.S. or R.C.E. No.: L.S. 4450




## COUNTY SURVEYOR'S STATEMENT


This Corner Record was received August 22, 2013 and examined  
and filed September 3, 2013.

Signed Thomas M. Gau P.L.S. or R.C.E. No.: 26994

Title County Surveyor

County Surveyor's Comment \_\_\_\_\_

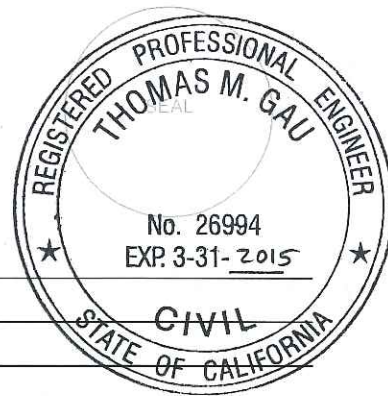

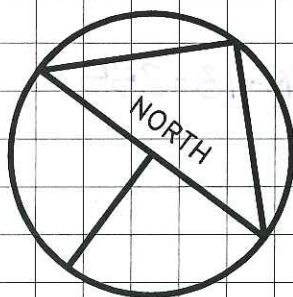

SCALE: 1" = 40'  
2013-118

**AVENUE**

**OXFORD**

GREGORY G. BURGIN  
DOC. NO. 2012-030698  
LOT 6  
BLOCK 1  
M. & P. 10-115

JERRY L. AND  
GIORGINA SWANSON  
DOC. NO. 2010-165156  
LOT 7

PATRICIA BUSH  
DOC. NO. 2010-145564  
LOT 5

**CLARENDON**

**WAY**

FD. CHISELED  
CROSS PER (D)

FD. CHISELED  
CROSS NO  
REFERENCE

FD. CHISELED  
CROSS NO  
REFERENCE

FD. CHISELED  
CROSS NO  
REFERENCE

FD. CHISELED  
CROSS NO  
REFERENCE

FD. CHISELED  
CUT PER (B)

FD. CHISELED  
CUT PER (B)(C)

LOT 8

LOT LINE

UNFILED SURVEY DATED  
FEB. 4, 1931,  
FILE NO. 129-DD

LOT 4

LOT LINES

LOT 9

UNFILED SURVEY BY CHAS. H. WIDDOWS  
DATED OCT. 3, 1934, FILE NO. 682-BB

UNFILED SURVEY BY CHAS. H.  
WIDDOWS DATED SEPT. 28, 1935,  
FILE NO. 704-BB

LOT 3

LOT LINE

LOT 10

LOT LINE

## LEGEND

|          |                                                   |
|----------|---------------------------------------------------|
| +        | INDICATES FOUND CHISELED CROSS AS NOTED           |
| -        | INDICATES FOUND CHISELED CUT AS NOTED             |
| FD.      | INDICATES FOUND ON THIS SURVEY                    |
| M. & P.  | INDICATES MAPS AND PLATS, BOOK AND PAGE, S.J.C.R. |
| S.J.C.R. | INDICATES SAN JOAQUIN COUNTY RECORDS              |
| DOC. NO. | INDICATES DOCUMENT NUMBER, S.J.C.R.               |

## REFERENCES

- (A) M. & P. 10-115, S.J.C.R.
- (B) UNFILED SURVEY DATED FEB. 4, 1931, FILE NO. 129-DD
- (C) UNFILED SURVEY BY CHAS. H. WIDDOWS DATED SEPT. 28, 1935, FILE NO. 704-BB
- (D) UNFILED SURVEY BY CHAS. H. WIDDOWS DATED OCT. 3, 1934, FILE NO. 682-BB