

CORNER RECORD

Document Number CR-13-257City of ESCALONCounty of SAN JOAQUIN, CaliforniaBrief Legal Description MONUMENT AT THE NORTHWEST CORNER OF THE INTERSECTION OF YOSEMITE STREET AND SIERRA DRIVE LOCATED IN NORTHWEST QUARTER OF SECTION 4, T.2S, R.9E, M.D.B.&M.

CORNER TYPE

COORDINATES (Optional)

NW 1/4	NE 1/4
SW 1/4	SE 1/4

Government Corner ☐ Control ☐
Meander ☐ Property ☒
Rancho ☐ Other ☐

N _____
E _____
Zone _____ NAD27 ☐ NAD83 ☐
NAD83 Epoch _____
Elev. _____
Vert. Datum: NVGD29 ☐ NVGD88 ☐
Meas. Units: Metric ☐ Imperial ☒

SEC. 4 T.2S, R.9E

Date of Survey 6-3-2013

Corner— Left as found ☒ Found and tagged ☐ Established ☐ Reestablished ☐ Rebuilt ☐

Identification and type of corner found: Evidence used to identify or procedure used to establish or reestablish the corner:
FOUND 1" REBAR WITH BRASS TAG RCE 1014 AT THE NORTHWEST CORNER OF THE INTERSECTION OF
YOSEMITE STREET AND SIERRA DRIVE, LOCATED IN SECTION 4, T.2S, R.9E, M.D.B.&M. FOUND MONUMENT
AS SHOWN ON RECORD MAP FILED IN VOLUME 11 OF MAPS AT PAGE 120, SAN JOAQUIN COUNTY RECORDS.

A description of the physical condition of the monument as found and as set or reset: _____
MONUMENT IS IN AREA OF RECONSTRUCTION, SET TIES AS SHOWN ON PAGE 2.

SURVEYOR'S STATEMENT

This Corner Record was prepared by me or under my direction in conformance with
the Land Surveyors' Act on AUGUST 5, 2013,



Signed [Signature] P.L.S. or R.C.E. Number 6953


COUNTY SURVEYOR'S STATEMENT

This Corner Record was received August 7, 2013 and examined
and filed August 23, 2013

Signed [Signature] P.L.S. or R.C.E. No: 26994

Title County Surveyor

County Surveyor's Comment _____

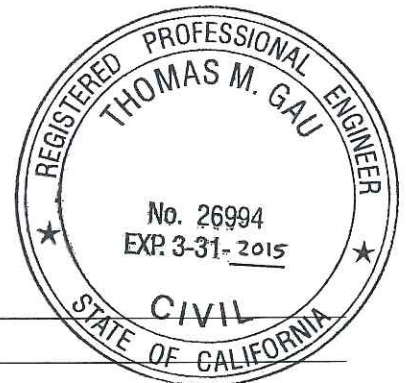

LEGEND:

- ⊗ SET MONUMENT AS NOTED
● FOUND MONUMENT AS NOTED.
S.J.C.R. DENOTES SAN JOAQUIN COUNTY RECORDS
R.M. DENOTES RECORD MAPS
(M) MEASURED DISTANCE. ALL DISTANCES ARE
MEASURED UNLESS NOTED OTHERWISE.

REFERENCE:

(R1) R.M. 11-120, S.J.C.R.

