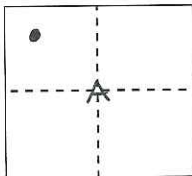


CORNER RECORD

Document Number CR-13-258City of Stockton (APN 110-010-02)County of San Joaquin, CaliforniaBrief Legal Description Found EMBUD monument in aqueduct R/W, near Mc Gaw St. and March Ln.SECTION A,
WEBER GRANT**CORNER TYPE**

Government Corner	<input type="checkbox"/>	Control	<input checked="" type="checkbox"/>
Meander	<input type="checkbox"/>	Property	<input type="checkbox"/>
Rancho	<input type="checkbox"/>	Other	<input type="checkbox"/>

Date of Survey February 25, 2013**COORDINATES (Optional)**

N.					
E.					
Zone	<u></u>	NAD27	<input type="checkbox"/>	NAD83	<input type="checkbox"/>
NAD83 Epoch	<u></u>				
Elev.	<u></u>				
Vert. Datum:	NGVD29	<input type="checkbox"/>	NAVD88	<input type="checkbox"/>	
Meas. Units:	Metric	<input type="checkbox"/>	Imperial	<input checked="" type="checkbox"/>	

Corner - Left as found ☐ Found and tagged ☐ Established ☐ Reestablished ☒ Rebuilt ☐

Identification and type of corner found: Evidence used to identify or procedure used to establish or reestablish the corner:

An existing East Bay Municipal Utility District (EBMUD) brass disc monument, as noted on page 2, was found on top of a concrete manway structure marking the centerline of the existing aqueduct and control for the corridor R/W.

A description of the physical condition of the monument as found and as set or reset:

The found monument was referenced with 4 RPs representing two intersecting lines then replaced with a new brass disc as described on page 2.


Reference EBMUD Field Book 4449, Page 58 (Poulsen/ Clarke)

SURVEYOR'S STATEMENT

This Corner Record was prepared by me or under my direction in conformance with the Professional Land Surveyor's Act on July 3, 2013

Signed R. Lee Hixson P.L.S. or R.C.E. No. 4806**COUNTY SURVEYOR'S STATEMENT**This Corner Record was received July 17, 2013and examined and filed August 22, 2013Signed Thomas M. Gau P.L.S. or R.C.E. No. 26994Title County Surveyor

County Surveyor's Comment: _____

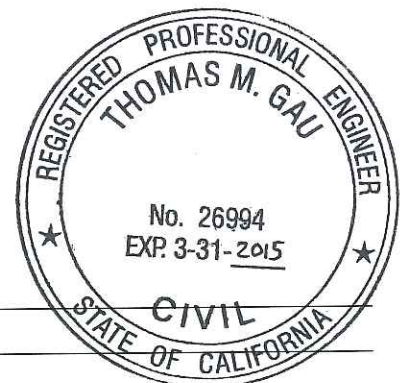

STOCKTON

SAN JOAQUIN CO.

MARCH LN.

MOKELUMNE AQUEDUCT
EBMUD R/W
APN 110-010-02

MC GAW ST.
60' R/W

MOKELUMNE AQUEDUCT
EBMUD R/W
APN 110-010-02

4612 MC GAW ST.
APN 110-150-01

1919 GRAND CANAL BLVD.
APN 110-330-16

LEGEND

- FOUND 2½" BRASS DISK ON CONCRETE MANWAY STRUCTURE ON C/L AQUEDUCT #1; REPLACED WITH 3½" BRASS DISC STAMPED "EBMUD P1794+63.54, H1794+43.13, EBMUD SURVEY, RESET 2013" OLD ELEV=6.28' NEW ELEV=7.84 (AQU. DATUM)
- SET CONCRETE ANCHOR NAIL AND 1½" BRASS WASHER STAMPED "EBMUD RP" IN TOP OF CONCRETE CURB.
- △ SET ½" RE-BAR WITH YELLOW PLASTIC CAP STAMPED "EBMUD RP"
- ◻ SET PK NAIL AND 1½" BRASS WASHER STAMPED "EBMUD RP" IN AC PARKING LOT



SCALE:
1"=30'