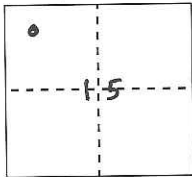


CORNER RECORD

Document Number CR-13-268City of (APN 053-150-08)County of San Joaquin, CaliforniaBrief Legal Description Found EMBUD monument in aqueduct R/W, near 14920 Atkins Road.**CORNER TYPE**

Government Corner	<input type="checkbox"/>	Control	<input checked="" type="checkbox"/>
Meander	<input type="checkbox"/>	Property	<input type="checkbox"/>
Rancho	<input type="checkbox"/>	Other	<input type="checkbox"/>

COORDINATES (Optional)

N.				
E.				
Zone	<u>NAD27</u>	<input type="checkbox"/>	<u>NAD83</u>	<input type="checkbox"/>
NAD83 Epoch				
Elev.				
Vert. Datum:	<u>NGVD29</u>	<input type="checkbox"/>	<u>NAVD88</u>	<input type="checkbox"/>
Meas. Units:	<u>Metric</u>	<input type="checkbox"/>	<u>Imperial</u>	<input checked="" type="checkbox"/>

S1S, T3N, R8E, MDM

Date of Survey November 1, 2011Corner - Left as found ☐ Found and tagged ☐ Established ☐ Reestablished ☒ Rebuilt ☐

Identification and type of corner found: Evidence used to identify or procedure used to establish or reestablish the corner:
An existing East Bay Municipal Utility District (EBMUD) brass disc monument, as noted on Page 2, was found on top of a concrete manway structure marking the centerline of the existing aqueduct and control for the corridor R/W.

A description of the physical condition of the monument as found and as set or reset:

The found monument was referenced with 4 RPs representing two intersecting lines then replaced with a new brass disc as described on Page 2.

Reference EBMUD Field Book 4449, Page 18 (Poulsen/Chou)

SURVEYOR'S STATEMENT

This Corner Record was prepared by me or under my direction in conformance with the Professional Land Surveyor's Act on July 3, 2013

Signed

P.L.S. or R.C.E. No.


4806**COUNTY SURVEYOR'S STATEMENT**This Corner Record was received July 17, 2013and examined and filed August 22, 2013

Signed

P.L.S. or R.C.E. No.

26994

Title

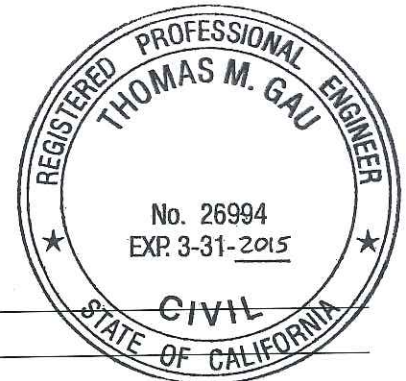County Surveyor

County Surveyor's Comment:

SAN JOAQUIN CO.

LODI

14920 ATKINS ROAD
APN 053-150-08

14298 ATKINS ROAD
APN 053-150-07

LEGEND

- FOUND 2-1/2" BRASS DISC IN CONCRETE MANWAY PER EBMUD R/W MAP 4195-G-141; REPLACED WITH 3-1/2" DIAMETER BRASS PLATE, STAMPED "EBMUD SURVEY, RESET 2011, PL963+92.92/ P914+05.08", NEW ELEVATION=124.407'. OLD ELEV.=121.31, NEW ELEV.=124.39' (AQUEDUCT DATUM),
- SET 1/2" REBAR AND YELLOW PLASTIC CAP, "EBMUD RP"
- SET 2x2 HUB WITH TACK AND SHINER



SCALE
1"=30'



ADDRESS: 14920 ATKINS ROAD
APN: 053-150-08

CR#

CR