
CORNER RECORD Document Number _ CR-13-283 City of __ County of San Joaquin, California MARIPOSA ROAD 1308' +/- NORTHWEST OF BRENNAN ROAD Brief Legal Description _ WITHIN SECTION 18, TOWNSHIP 1 SOUTH, RANGE 9 EAST, MOUNT DIABLO BASE & MERIDIAN **CORNER TYPE** COORDINATES (Optional) Government Corner Control NAD27 ☐ NAD83 ☐ Meander Property NAD83 Epoch Rancho Other Elev. Vert. Datum: NGVD29 □ NAVD88 Date of Survey July 15, 2013 Meas. Units: Metric ☐ Imperial ☒ Corner -Left as found Found and tagged □ Established Reestablished Rebuilt Identification and type of corner found: Evidence used to identify or procedure used to establish or reestablish the corner: SEE SKETCH ON BACKSIDE. A description of the physical condition of the monument as found and as set or reset:_____ SEE SKETCH ON BACKSIDE. SURVEYOR'S STATEMENT This Corner Record was prepared by me or under my direction in conformance with August 22 the Land Surveyors' Act on Signed ___ P.L.S. Number___8657 LICENSE No. 865 COUNTY SURVEYOR'S STATEMENT This Corner Record was received August 26, 2013 and examined and filed September 10 , 2013. TELL R.C.E. No. 26994 Signed Title County Surveyor County Surveyor's Comment_____ (D.D. Sheet No. 43)

(Job No. 220078)



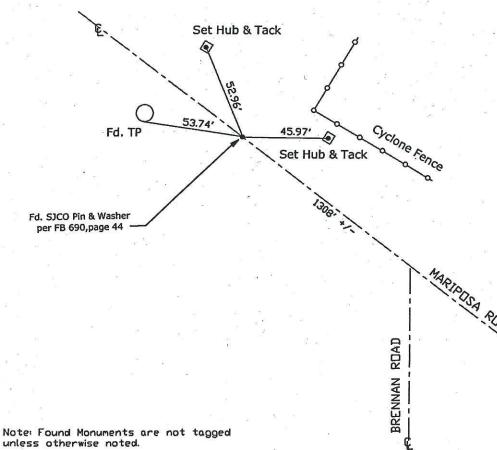

Note: Found Monuments are not tagged

"No Attempt Was Made to Verify the Monument(s)"

Set=Conc. Nail with Brass Washer Stamped
"S.J. Co.", unless atherwise noted
Fd.=Found Conc. Nail with Brass Washer Stamped
"S.J. Co.", unless otherwise noted
CR=Corner Record
FP=Fence Post
JP=Joint Pole
LP=Light Pole
PP=Power Pole
GP=Guy Pole
SP=Service Pole
TP=Telephone Pole TP=Telephone Pole S.F.N.=Searched Found Nothing N.T.S.=Not To Scale
M&P=Maps & Plats
PM=Parcel Map
RS=Record of Survey
FB=Field Book