


CORNER RECORD

Document Number CR-13-288
 County of San Joaquin, California

City of Lathrop

Brief Legal Description Lots 86-91, Per M.&P. 40-5, S.J.C.R.

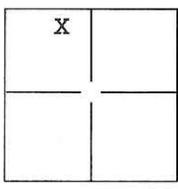

S 34, T1S, R6E

CORNER TYPE

Government Corner Control
 Meander Property
 Rancho Other

Date of Survey August 3, 2013

COORDINATES(Optional)

N. _____
 E. _____
 Zone _____ NAD27 NAD83
 NAD83 Epoch _____
 Elev. _____
 Vert. Datum: NGVD29 NADV88
 Meas. Units: Metric Imperial

Corner - Left as found Found and tagged Established Reestablished Rebuilt

Identification and type of corner found: Evidence used to identify or procedure used to establish or reestablish the corner:

Found Slashes at the projection of the side Lot Lines of Lots 86-91. (See Attached Sketch)

Found brass disc in monument boxes per M.&P. 40-5, S.J.C.R.

A description of the physical condition of the monument as found and as set or reset: Set 1/2" x 24" Iron Pipes tagged L.S. 4450 at a 2' offset from the rear lot corners of Lots 86-91. (See Attached Sketch)

SURVEYOR'S STATEMENT

This Corner Record was prepared by me or under my direction in conformance with the Land Surveyor's Act on September 3, 2013.

Signed Michael L. Quartaroli P.L.S. or R.C.E. No.: L.S. 4450



COUNTY SURVEYOR'S STATEMENT


This Corner Record was received September 4, 2013 and examined and filed September 23, 2013.

Signed Thomas M. Gau P.L.S. or R.C.E. No.: 26994

Title County Surveyor

County Surveyor's Comment _____



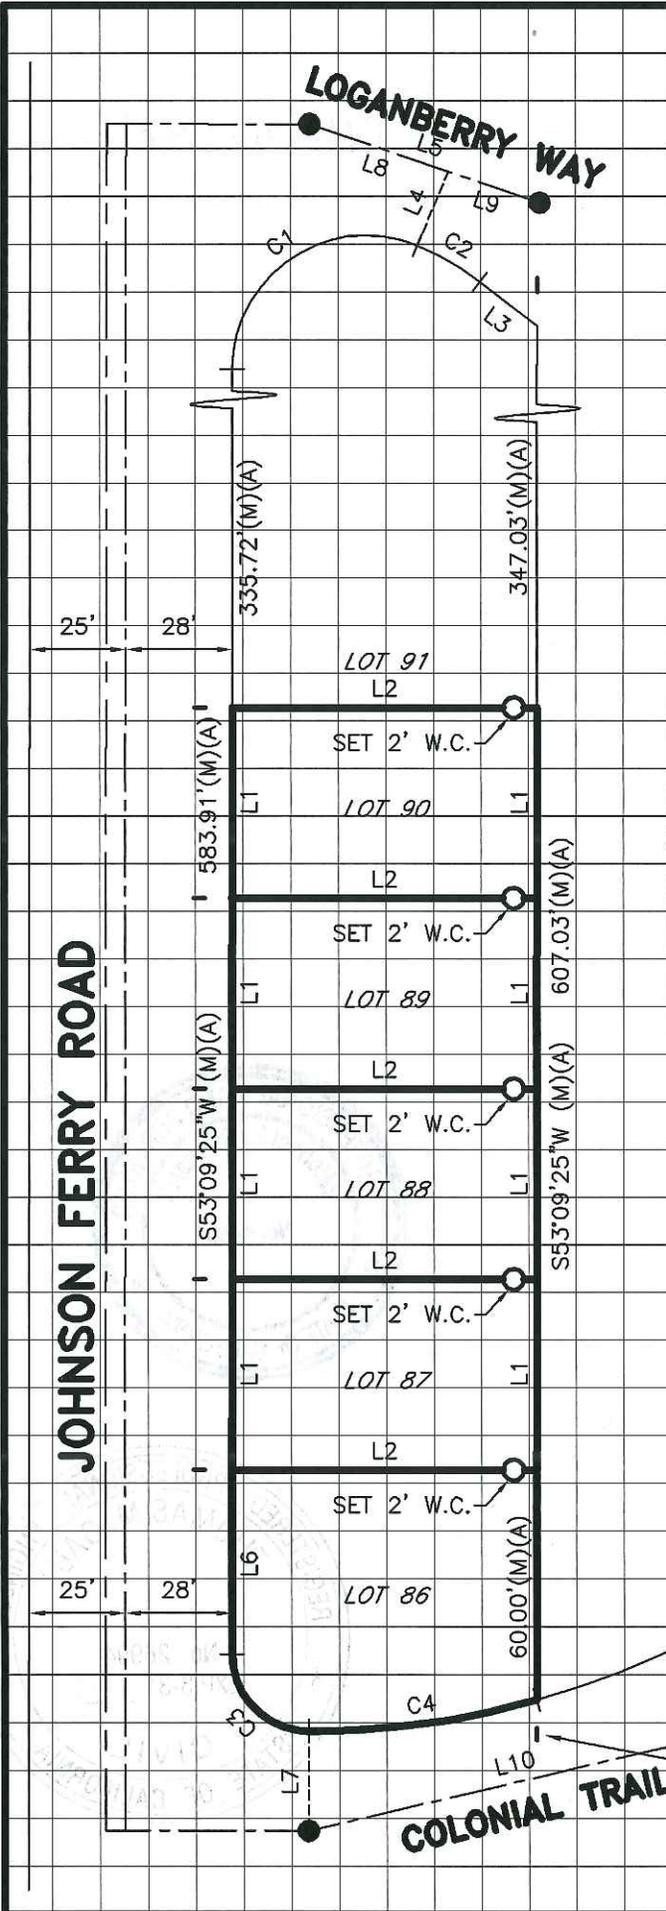

REFERENCE

(A) M. & P. 40-5, S.J.C.R.

LEGEND


- INDICATES FOUND BRASS DISC IN MON. WELL STAMPED L.S. 5412 PER (A)
- INDICATES SET 1/2" X 24" IRON PIPE TAGGED L.S. 4450
- INDICATES FOUND SLASH PER (A)
- FD. INDICATES FOUND ON THIS SURVEY
- (M) INDICATES MEASURED THIS SURVEY
- M. & P. INDICATES MAPS AND PLATS, BOOK AND PAGE, S.J.C.R.
- I.N. INDICATES INSTRUMENT NUMBER, S.J.C.R.
- DOC. NO. INDICATES DOCUMENT NUMBER, S.J.C.R.
- O.R. INDICATES OFFICIAL RECORDS, VOLUME AND PAGE, S.J.C.R.
- S.J.C.R. INDICATES SAN JOAQUIN COUNTY RECORDS

LINE TABLE

LINE	BEARING	DISTANCE
L1	S53°09'25"W (M)(A)	50.00'(M)(A)
L2	N36°50'35"W (M)(A)	80.00'(M)(A)
L3	S00°29'28"W (M)(A)	19.01'(M)(A)
L4	S75°46'37"W (M)(A)	20.97'(M)(A)
L5	S18°10'33"E (M)(A)	64.01'(M)(A)
L6	S53°09'25"W (M)(A)	48.19'(M)(A)
L7	S53°09'25"W (M)(A)	26.00'(M)(A)
L8	S18°10'33"E (M)(A)	38.55'(M)(A)
L9	S18°10'33"E (M)(A)	25.46'(M)(A)
L10	S50°00'34"E (M)(A)	113.89'(M)(A)

CURVE TABLE

CURVE	R	L	Δ
C1	R=35.00'(M)(A)	L=68.80'(M)(A)	Δ=112°37'12"(M)(A)
C2	R=74.00'(M)(A)	L=19.00'(M)(A)	Δ=14°42'52"(M)(A)
C3	R=20.00'(M)(A)	L=31.42'(M)(A)	Δ=90°00'00"(M)(A)
C4	R=224.00'(M)(A)	L=60.74'(M)(A)	Δ=15°32'12"(M)(A)

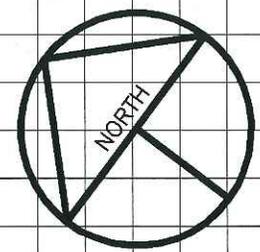

SCALE: 1" = 50'
2013-155