
CORNER RECORD			Document Number CR-13-30			
City of		County	of	San Joaquin,	Californic	
Brief Legal Description _	JAHANT ROAD @ PEARL ROAD		a h	1	₹ W	
					A.	
<u> </u>	CORNER TYPE			ORDINATES (Op		
	Government Corner 🗵 Control 🗆	N E			***************************************	
12	Meander □ Property □			NAD27		
	Rancho ☐ Other ☑	Elev.	os choc	h	**************************************	
	Date of Survey September 3, 2013			: NGVD29 ☐ Metric ☐		
T4N R7E MDB&M		MCG	J. OT 1113.	Meme L	imperiar Z	
Corner - Left as fou	nd Found and tagged Established	d □ Red	establish	ned 🛛 Reb	uilt (🗆 -	
-				-		
Identification and type	of corner found: Evidence used to identify or	procedure u	sed to e	stablish or reesto	ablish the corner	
SEE SKETCH ON BACKSIE	**					
Special and the second						
T Comment of the Comm	is a second seco	-	manda in transcription	1		
		***************************************			CO S COMPANION COMPA	
· Charles All	S I	Y.	L-1-10-00	·		
SEE SKETCH ON BACKSIE	DE.		¥			
	SURVEYOR'S STATEMENT		ů.	ONAL	LAND	
This Corner Record was the Land Surveyors' A	prepared by me or under my direction in cor ct onOctober 10, 2013.	itormance wi	th	SOMES	E. WAR	
Signed Dames	E Hart P.L.S. Number 8657			1191	NSE S	
					8657	
	DUNTY SURVEYOR'S STATEMENT as received 0 c to be 10 2013 and	v		1/2/5	12/0/2	
This Corner Record we	/ 1000 m	d examined		OF C	1511685/	
and filed U. 101	DEV 18 , 2013.		NAT.	Or C	ALI	
Signed	r.C.E. No.	26994	-	OROFES.	SION	
Title County Surveyo	Dr.	*		SUD MAS	M. C.S.	
County Surveyor's Co	mment		- <u> </u>		艺剧	
				以 EXP. 3-		
				1/02/		
(D.D. Sheet No. 10)				Mark Control	TEOBY.	
(Job No. 220056)	×.			Mar C	ALI	

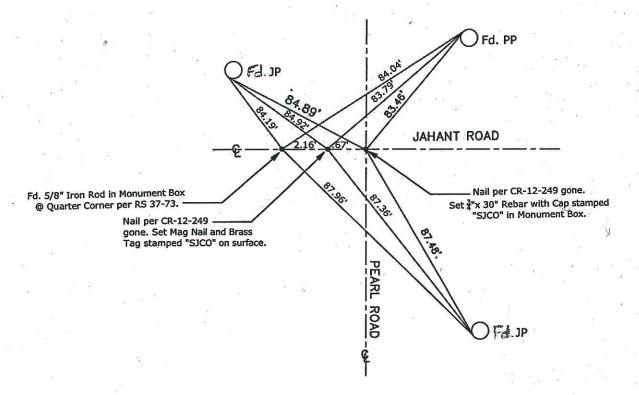

N.T.S.



Note: Found Monuments are not tagged unless otherwise noted.

"No Attempt Was Made to Verify the Monument(s)"

Set=Conc. Nail with Brass Washer Stamped
"S.J. Co.", unless otherwise noted
Fd.=Found Conc. Nail with Brass Washer Stamped
"S.J. Co.", unless otherwise noted
CR=Corner Record
FP=Fence Post
JP=Joint Pole
LP=Light Pole
LP=Light Pole
PP=Power Pole
GP=Guy Pole
SP=Service Pole
TP=Telephone Pole
SF.N.=Searched Found Nothing
N.T.S.=Not To Scale
M&P=Maps & Plats
PM=Parcel Map
RS=Record of Survey
FB=Field Book
IP = Intersection Point