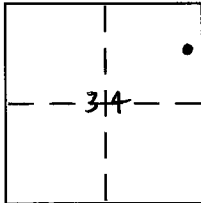


# CORNER RECORD

Document Number CR-13-314City of UNINCORPORATED County of SAN JOAQUIN, CaliforniaBrief Legal Description PARCEL A -- 7 P.M. 87

TZS, RTE, MDM

## CORNER TYPE

Government Corner ☐ Control ☐  
Meander ☐ Property ☒  
Rancho ☐ Other ☐  
Date of Survey 9/11/13

## COORDINATES (Optional)

N. \_\_\_\_\_  
E. \_\_\_\_\_  
Zone \_\_\_\_\_ NAD27 ☐ NAD83 ☐  
NAD83 Epoch \_\_\_\_\_  
Elev. \_\_\_\_\_  
Vert. Datum: NGVD29 ☐ NAVD88 ☐  
Meas. Units: Metric ☐ Imperial ☒

Corner - Left as found ☒ Found and tagged ☐ Established ☐ Reestablished ☒ Rebuilt ☐


Identification and type of corner found: Evidence used to identify or procedure used to establish or reestablish the corner:

SET N.E. CORNER IN RECORD POSITION.  
SET N.W. CORNER AT RECORD DISTANCE  
PARALLEL WITH SOUTH LINE OF PARCELS  
A & B AS MEASURED FROM FOUND MONUMENTS.

A description of the physical condition of the monument as found and as set or reset: \_\_\_\_\_

FOUND REBARS IN GENERALLY GOOD CONDITION  
AS PER 7 P.M. 87. SET CORNERS AS  
SHOWN ON SKETCH.


## SURVEYOR'S STATEMENT

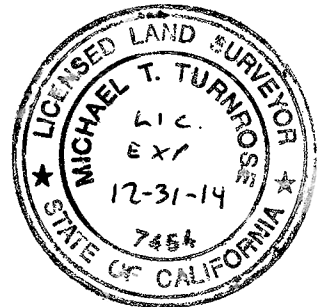This Corner Record was prepared by me or under my direction in conformance with  

## COUNTY SURVEYOR'S STATEMENT

This Corner Record was received October 23, 2013and examined and filed November 17, 2013Signed Thomas M. Gau (P.L.S. or R.C.E. No. 26994)Title County Surveyor

County Surveyor's Comment \_\_\_\_\_

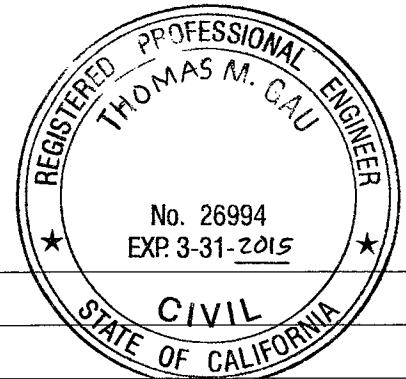

**LEGEND & NOTES:**

- INDICATES SET 3/4" x 30" IRON PIPE WITH PLASTIC PLUG STAMPED "TURNROSE L.S. 7454"
- INDICATES FOUND STREET MONUMENT BOX AS NOTED PER (A)
- INDICATES FOUND 3/4" REBAR OR AS NOTED AS PER (A)
- (A) INDICATES DATA TAKEN FROM 7 P.M. 87 OR CALCULATED THEREFROM
- (M) INDICATES MEASURED PER THIS SURVEY  
SFNF INDICATES SEARCHED FOR NOT FOUND

DISTANCES SHOWN ARE IN FEET AND DECIMALS THEREOF.

SCALE: 1" = 100'

1" IRON PIN WITH WASHER L.S. 2239  
N.E. CORNER  
SECT. 34  
AS PER (A)

60' WIDE  
AS PER (A)  
**AUSTIN RD.**

7 P.M. 87

**PARCEL B**

MONUMENT AS PER  
(A)---SFNF

631.07 (M) (A)  
S89°56'05" W

MONUMENT AS PER  
(A)---SFNF

207.50 (A)  
207.44 (M)  
N0°19'49" W

**PARCEL A**

MONUMENT AS PER  
(A)---SFNF---NOTHING  
SET

40' WIDE  
AS PER (A)  
**MELTON RD.**

661.04 (A)  
661.10 (M)

N89°56'05" E

601.04 (A)  
601.02 (M)

N89°56'05" E

FOUND 1" REBAR

35.98 (A)  
S55°08'00" W

187.49 (M) (A)  
S0°20'05" E

1321.51 (M) 1321.41 (A)  
N0°20'05" W

FOUND BENT---STRAIGHTENED  
AND RESET IN SAME  
POSITION---S0°20'E 0.05'

1/4 1/4 SECT. LINE  
AS PER (A)

FOUND 1" GINNY  
IN MON. BOX---  
ACCEPTED AS BEING  
IN LOCATION PER (A)  
SURVEY WORK CONDUCTED  
DURING COUNTY RESURFACING  
PROJECT