

# CORNER RECORD

Document Number CR-13-315  
City of ESCALON County of SAN JOAQUIN, California

Brief Legal Description MONUMENT AT THE NORTHWEST CORNER OF THE INTERSECTION OF YOSEMITE STREET AND SIERRA DRIVE LOCATED IN NORTHWEST QUARTER OF SECTION 4, T.2S, R.9E, M.D.B.&M.

## CORNER TYPE

## COORDINATES (Optional)

NW 1/4	NE 1/4
SW 1/4	SE 1/4

Government Corner ☐ Control ☐  
Meander ☐ Property ☒  
Rancho ☐ Other ☐

N \_\_\_\_\_  
E \_\_\_\_\_  
Zone \_\_\_\_\_ NAD27 ☐ NAD83 ☐  
NAD83 Epoch \_\_\_\_\_  
Elev. \_\_\_\_\_  
Vert. Datum: NVGD29 ☐ NVGD88 ☐  
Meas. Units: Metric ☐ Imperial ☒

SEC. 4 T.2S, R.9E

Date of Survey 8-1-2013

Corner— Left as found ☐ Found and tagged ☐ Established ☐ Reestablished ☒ Rebuilt ☐

Identification and type of corner found: Evidence used to identify or procedure used to establish or reestablish the corner:  
FOUND 1" REBAR WITH BRASS TAG RCE 1014 AT THE NORTHWEST CORNER OF THE INTERSECTION OF  
YOSEMITE STREET AND SIERRA DRIVE, LOCATED IN SECTION 4, T.2S, R.9E, M.D.B.&M. FOUND MONUMENT  
AS SHOWN ON RECORD MAP FILED IN VOLUME 11 OF MAPS AT PAGE 120, SAN JOAQUIN COUNTY RECORDS.

A description of the physical condition of the monument as found and as set or reset: \_\_\_\_\_  
SET CONCRETE NAIL WITH BRASS TAG STAMPED L.S. 6953 FROM TIES AS SHOWN ON PAGE 2.

## SURVEYOR'S STATEMENT

This Corner Record was prepared by me or under my direction in conformance with  
the Land Surveyors' Act on SEPTEMBER 1, 2013,

Signed [Signature] P.L.S. or R.C.E. Number 6953




## COUNTY SURVEYOR'S STATEMENT

This Corner Record was received October 24, 2013 and examined  
and filed November 11, 2013

Signed [Signature] P.L.S. or R.C.E. No: 26994

Title County Surveyor

County Surveyor's Comment \_\_\_\_\_

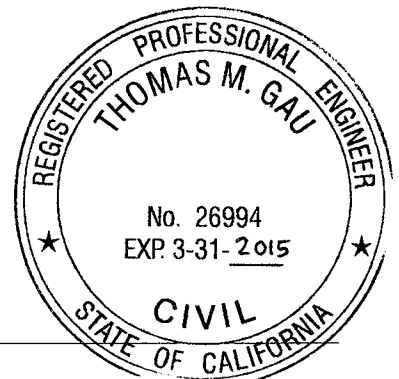

# LEGEND:

- ⊗ SET MONUMENT AS NOTED
- FOUND MONUMENT AS NOTED.
- S.J.C.R. DENOTES SAN JOAQUIN COUNTY RECORDS
- R.M. DENOTES RECORD MAPS
- (M) MEASURED DISTANCE. ALL DISTANCES ARE MEASURED UNLESS NOTED OTHERWISE.

## REFERENCE:

- (R1) R.M. 11-120, S.J.C.R.
- (R2) CR 13-257, S.J.C.S.R.

