

CORNER RECORD

Document Number CR-13-350City of LATHROPCounty of SAN JOAQUIN, CaliforniaBrief Legal Description MONUMENT AT THE INTERSECTION OF D'ARCY PARKWAY AND MURPHY PARKWAY
LOCATED IN SECTION 34, T.1S, R.6E, M.D.B.&M.

CORNER TYPE

COORDINATES (Optional)

NW 1/4	NE 1/4
SW 1/4	SE 1/4

Government Corner	<input type="checkbox"/>	Control	<input type="checkbox"/>
Meander	<input type="checkbox"/>	Property	<input type="checkbox"/>
Rancho	<input type="checkbox"/>	Other	<input checked="" type="checkbox"/>

N _____
E _____
Zone _____ NAD27 ☐ NAD83 ☐
NAD83 Epoch _____
Elev. _____
Vert. Datum: NVGD29 ☐ NVGD88 ☐
Meas. Units: Metric ☐ Imperial ☒

SEC. 34 T.1S, R.6E

Date of Survey 10-23-2013Corner— Left as found ☒ Found and tagged ☐ Established ☐ Reestablished ☐ Rebuilt ☐

Identification and type of corner found: Evidence used to identify or procedure used to establish or reestablish the corner:
FOUND 5/8" REBAR WITH 1" CAP RCE 24029 IN MONUMENT WELL, AT THE INTERSECTION OF MURPHY
PARKWAY AND D'ARCY PARKWAY. LOCATED IN SECTION 34, T.1S, R.6E, M.D.B.&M. FOUND MONUMENT AS
SHOWN ON RECORD MAP FILED IN BOOK 31 OF MAPS AT PAGE 70, SAN JOAQUIN COUNTY RECORDS.

A description of the physical condition of the monument as found and as set or reset:
MONUMENT IS IN AREA OF RECONSTRUCTION, SET TIES AS SHOWN ON PAGE 2.

SURVEYOR'S STATEMENT

This Corner Record was prepared by me or under my direction in conformance with
the Land Surveyors' Act on NOVEMBER 12, 2013,


Signed [Signature] P.L.S. or R.C.E. Number 6953

COUNTY SURVEYOR'S STATEMENT

This Corner Record was received November 20, 2013 and examined
and filed December 1, 2013

Signed Thomas M. Gau P.L.S. or R.C.E. No: 26994Title County Surveyor

County Surveyor's Comment _____

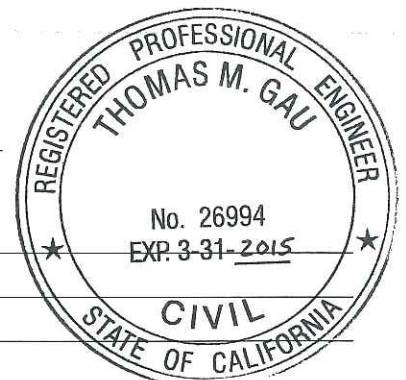

LEGEND:

- ⊗ SET MONUMENT AS NOTED
- FOUND MONUMENT AS NOTED.
- S.J.C.R. DENOTES SAN JOAQUIN COUNTY RECORDS
- M.&P. DENOTES MAPS AND PLATS
- R.S. DENOTES RECORD OF SURVEYS
- (M) MEASURED DISTANCE. ALL DISTANCES ARE MEASURED UNLESS NOTED OTHERWISE.

REFERENCE:

- (R1) M.&P. 31-70, S.J.C.R.
- (R2) R.S. 34-108, S.J.C.R.

