

# CORNER RECORD

Document Number CR-13-352  
City of LATHROP County of SAN JOAQUIN, California

Brief Legal Description MONUMENT WELL IN D'ARCY PARKWAY APPROXIMATELY 305'± NORTHWEST OF CHRISTOPHER WAY. LOCATED IN SECTION 35, T.1S, R.6E, M.D.B.&M.

|                |           |
|----------------|-----------|
| NW<br>1/4      | NE<br>1/4 |
| SW<br>1/4<br>● | SE<br>1/4 |

## CORNER TYPE

Government Corner ☐ Control ☐  
Meander ☐ Property ☐  
Rancho ☐ Other ☒

## COORDINATES (Optional)

N \_\_\_\_\_  
E \_\_\_\_\_  
Zone \_\_\_\_\_ NAD27 ☐ NAD83 ☐  
NAD83 Epoch \_\_\_\_\_  
Elev. \_\_\_\_\_  
Vert. Datum: NVGD29 ☐ NVGD88 ☐  
Meas. Units: Metric ☐ Imperial ☒

SEC. 35 T.1S, R.6E

Date of Survey 10-23-2013

Corner— Left as found ☒ Found and tagged ☐ Established ☐ Reestablished ☐ Rebuilt ☐

Identification and type of corner found: Evidence used to identify or procedure used to establish or reestablish the corner:  
FOUND EMPTY MONUMENT WELL WITH TWO (2), TWO FOOT SWING TIES IN THE PAVEMENT, IN D'ARCY PARKWAY APPROXIMATELY 305'± NORTHWEST OF CHRISTOPHER WAY. LOCATED IN SECTION 35, T.1S, R.6E, M.D.B.&M.

A description of the physical condition of the monument as found and as set or reset:  
MONUMENT IS IN AREA OF RECONSTRUCTION, SET TIES AS SHOWN ON PAGE 2.

## SURVEYOR'S STATEMENT

This Corner Record was prepared by me or under my direction in conformance with  
the Land Surveyors' Act on NOVEMBER 12, 2013,

Signed [Signature] P.L.S. or R.C.E. Number 6953



## COUNTY SURVEYOR'S STATEMENT


This Corner Record was received November 20, 2013 and examined

and filed December 1, 2013

Signed Thomas M. Gau P.L.S. or R.C.E. No: 26994

Title County Surveyor

County Surveyor's Comment \_\_\_\_\_

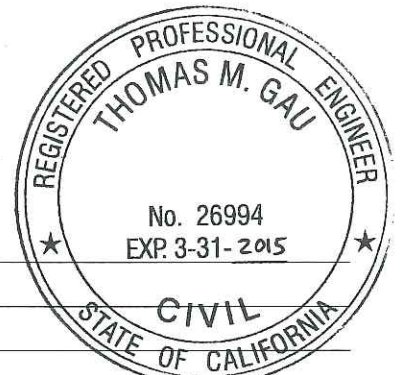



# LEGEND:

- ⊗ SET MONUMENT AS NOTED
- FOUND MONUMENT AS NOTED.
- S.J.C.R. DENOTES SAN JOAQUIN COUNTY RECORDS
- M.&P. DENOTES MAPS AND PLATS
- (M) MEASURED DISTANCE. ALL DISTANCES ARE MEASURED UNLESS NOTED OTHERWISE.



NOT TO SCALE

