

CORNER RECORD

Document Number CR-14-19


City of STOCKTON

County of SAN JOAQUIN, California

Brief Legal Description CENTER OF INTERSECTION OF STATE ROUTE 4 AND FRESNO AVE PER RECORD OF SURVEY VOL. 31 PAGE 167

CORNER TYPE

COORDINATES(Optional)

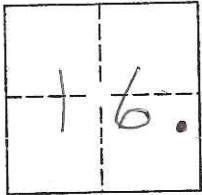

TIN RGE

Government Corner Control
Meander Property
Rancho Other

N. _____
E. _____
Zone _____ NAD27 NAD83
NAD83 Epoch _____
Elevation _____
Vert. Datum: NGVD29 NAV88
Meas. Units: Metric Imperial

Date of Survey SEPT. 10, 2013

Corner - Left as found Found and tagged Established Reestablished Rebuilt

Identification and type of corner found: Evidence used to identify or procedure used to establish or reestablish the corner:

FOUND 2 1/2" DIA. BRASS DISK IN CONCRETE IN MONUMENT WELL. AT THE CENTER OF THE INTERSECTION OF STATE ROUTE 4 (CHARTER WAY) AND FRESNO AVE. AS PER RECORD OF SURVEY VOL. 31 PAGE 167 AND PARCEL MAP VOL. 20 PAGE 38. SEE BACK OF CORNER RECORD FOR DISK STAMPING.

A description of the physical condition of the monument as found and as set or reset:

MONUMENT WAS FOUND IN GOOD CONDITION. SET OR LOCATED FOUR REFERENCE POINTS AND MEASURED DISTANCES TO MONUMENT

SURVEYOR'S STATEMENT

This Corner Record was prepared by me or under my direction in conformance with the Land Surveyor's Act on JANUARY 16, 2014.

Signed [Signature] P.L.S. or R.C.E. Number 8022
For the State of California
Department of Transportation




COUNTY SURVEYOR'S STATEMENT

This Corner Record was received January 22, 2014 and examined and filed February 14, 2014.

Signed Thomas M. Gau P.L.S. or R.C.E. Number 26994

Title County Surveyor

County Surveyor's Comment _____

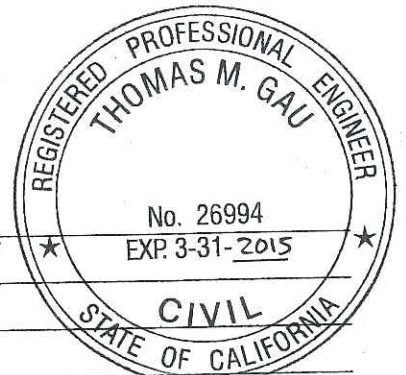



SET PUNCH MARK
IN NORTHEAST BOLT
OF SIGNAL LIGHT
BASE



FOUND 2 1/2" BRASS
DISK IN CONCRETE
IN MONUMENT WELL.
SEE STAMPING
ABOVE.




SET PUNCH MARK
IN SOUTHEAST BOLT
OF SIGNAL LIGHT
BASE.

FRESNO AVE

113.68'

STATE ROUTE 4
(CHARTER WAY)

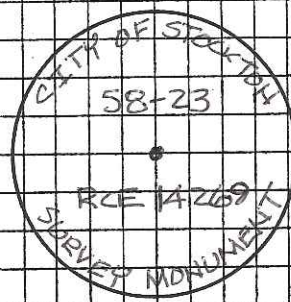

DISK STAMPING

FOUND 3/4" ID. IRON
PIPE WITH YELLOW
PLASTIC PLUG
STAMPED "RCE 14769"
DOWN 0.5'

FOUND 3/4" ID IRON
PIPE WITH YELLOW
PLASTIC PLUG STAMPED
"LS 5922",
DOWN 0.25'