


CORNER RECORD

Document Number CR-14-84

City of _____ County of San Joaquin, California

Brief Legal Description Parcel "1", Per Parcel Map 16-100, S.J.C.R.

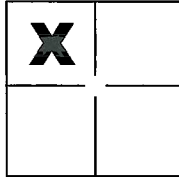

CORNER TYPE

Government Corner Control
 Meander Property
 Rancho Other

COORDINATES(Optional)

N. _____
 E. _____
 Zone _____ NAD27 NAD83
 NAD83 Epoch _____
 Elev. _____
 Vert. Datum: NGVD29 NADV88
 Meas. Units: Metric Imperial

Sec. 16, T.1S., R.9E.,
 M.D.B. & M.

Date of Survey April 28, 2014

Corner - Left as found Found and tagged Established Reestablished Rebuilt

Identification and type of corner found: Evidence used to identify or procedure used to establish or reestablish the corner:

The survey monuments at the witness corners were destroyed by drain canal reconstruction along the southerly side of Parcels "1", "2", "3" and "4" Per (A).

See Sheet 2


A description of the physical condition of the monument as found and as set or reset:

See Sheet 2

SURVEYOR'S STATEMENT

This Corner Record was prepared by me or under my direction in conformance with the Land Surveyor's Act on May 5, 2014.

Signed Michael L. Quartaon P.L.S. or R.C.E. No.: _____ L.S. 4450

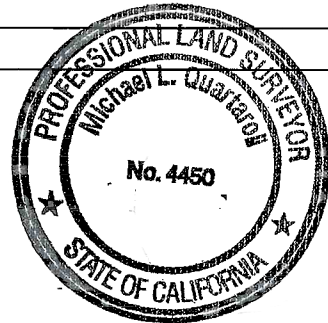


COUNTY SURVEYOR'S STATEMENT


This Corner Record was received May 7, 2014 and examined and filed June 2, 2014.

Signed Thomas M. Gau P.L.S. or R.C.E. No.: 26994


Title County Surveyor

County Surveyor's Comment _____

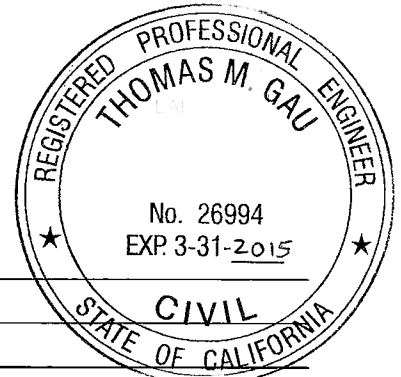

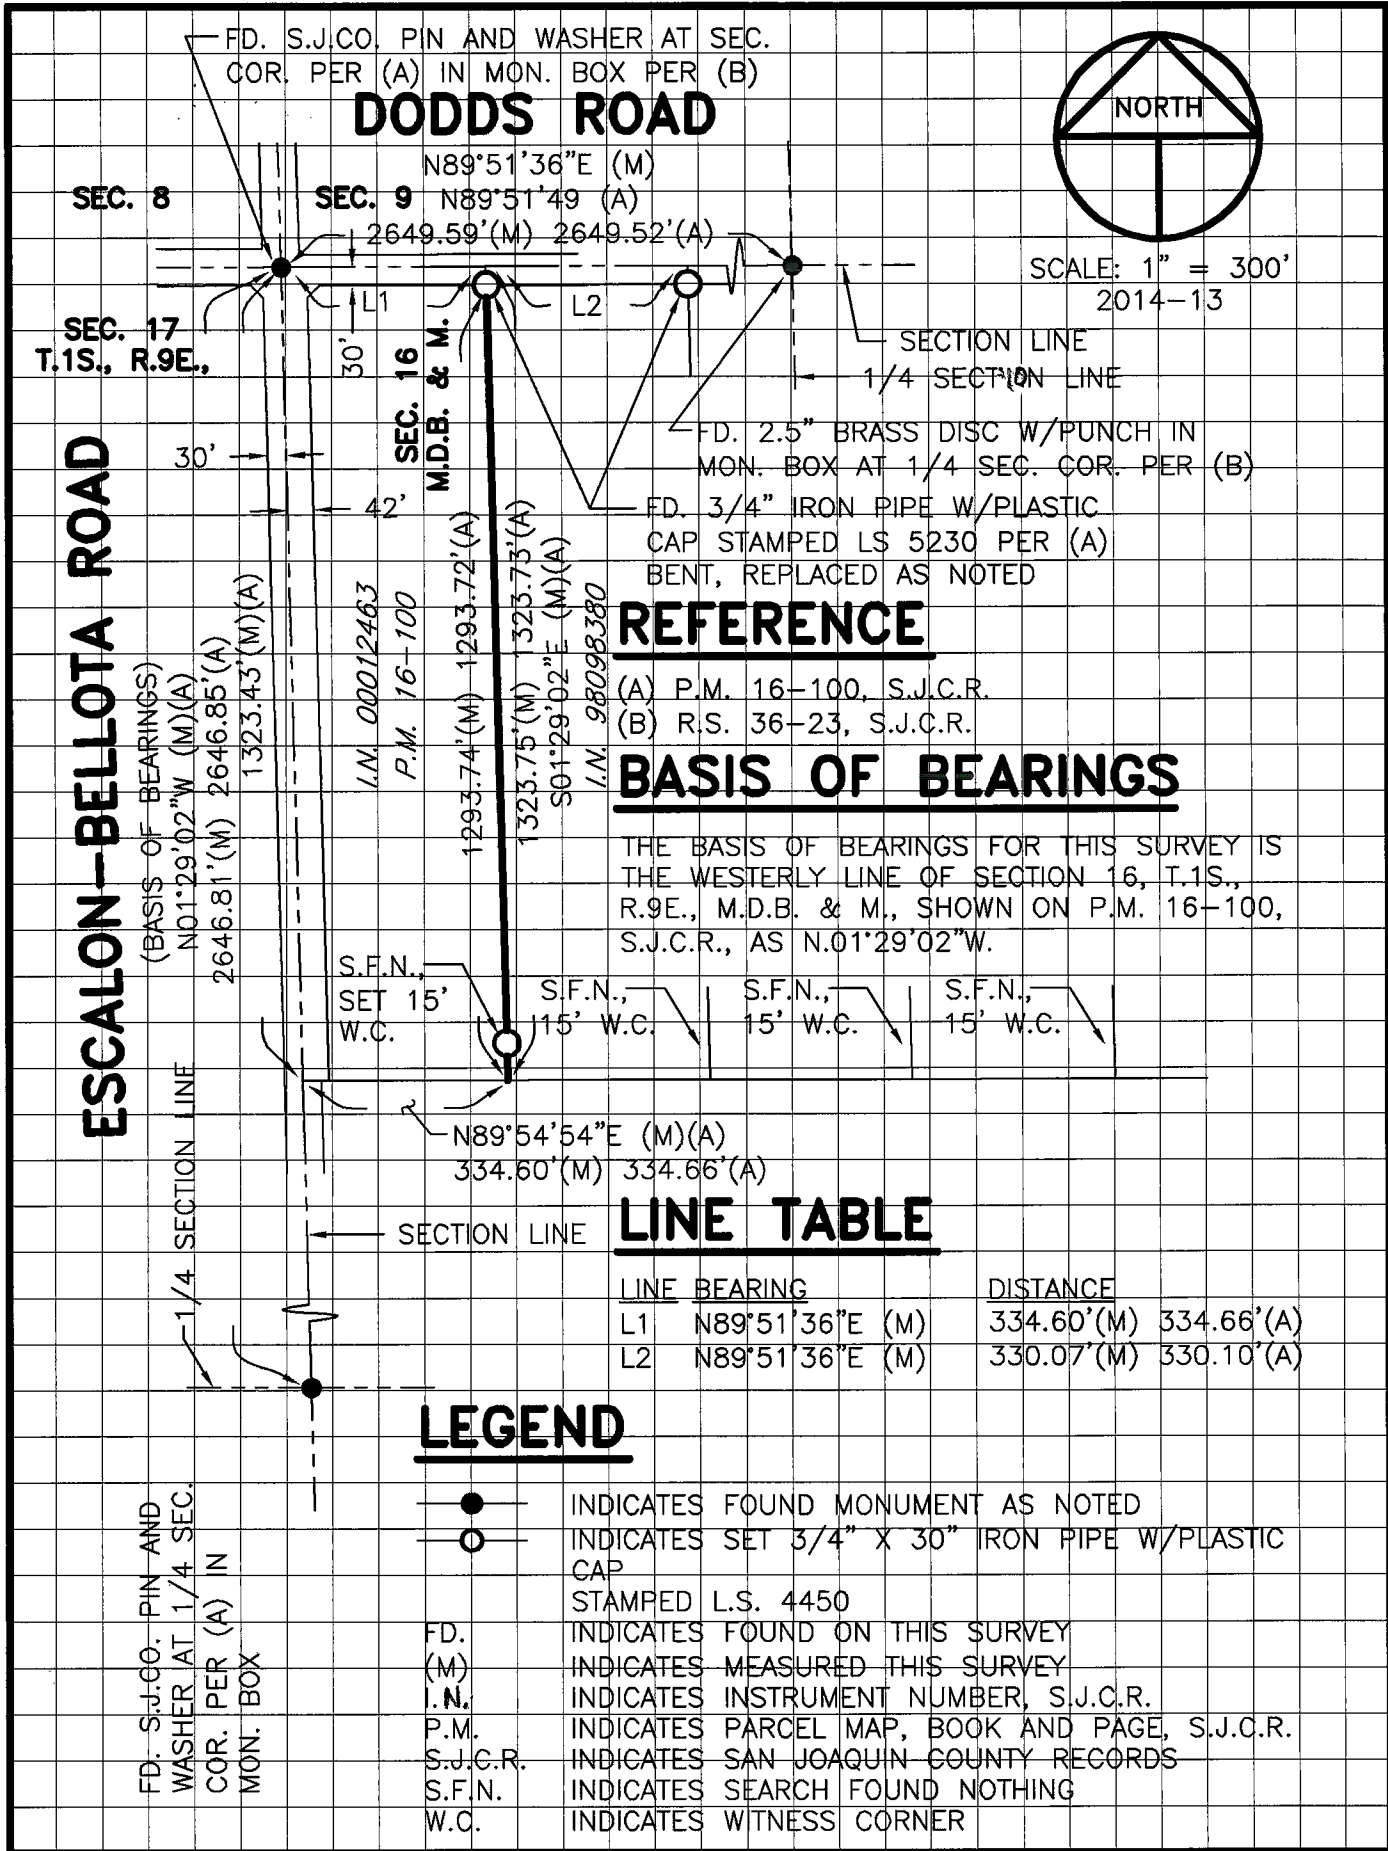

DODDS ROAD

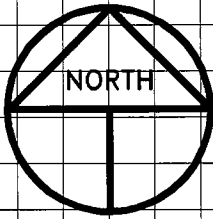

SCALE: 1" = 300'
2014-13

ESCALON-BELLOTA ROAD

REFERENCE

- (A) P.M. 16-100, S.J.C.R.
- (B) R.S. 36-23, S.J.C.R.

BASIS OF BEARINGS

THE BASIS OF BEARINGS FOR THIS SURVEY IS THE WESTERLY LINE OF SECTION 16, T.1S., R.9E., M.D.B. & M., SHOWN ON P.M. 16-100, S.J.C.R., AS N.01°29'02"W.

LINE TABLE

LINE	BEARING	DISTANCE
L1	N89°51'36"E (M)	334.60'(M) 334.66'(A)
L2	N89°51'36"E (M)	330.07'(M) 330.10'(A)

LEGEND

FD. S.J.CO. PIN AND WASHER AT 1/4 SEC. COR. PER (A) IN MON. BOX

- INDICATES FOUND MONUMENT AS NOTED
- INDICATES SET 3/4" X 30" IRON PIPE W/PLASTIC CAP STAMPED L.S. 4450
- FD. INDICATES FOUND ON THIS SURVEY
- (M) INDICATES MEASURED THIS SURVEY
- I.N. INDICATES INSTRUMENT NUMBER, S.J.C.R.
- P.M. INDICATES PARCEL MAP, BOOK AND PAGE, S.J.C.R.
- S.J.C.R. INDICATES SAN JOAQUIN COUNTY RECORDS
- S.F.N. INDICATES SEARCH FOUND NOTHING
- W.C. INDICATES WITNESS CORNER