

CORNER RECORD

Electronic File Number _____

Document Number CR-14-85

City of _____

County of San Joaquin, California

Brief Legal Description Quarter corner between Sections 35 & 36 T.1S., R. 9 E., M.D.M.

Sec 35	Sec 36

T.1S.,R.9E.,M.D.M.

CORNER TYPE

Government Corner Control
 Meander Property
 Rancho Other

Date of Survey Mar. 18, 2014

COORDINATES(Optional)

N. _____
 E. _____
 Zone _____ NAD27 NAD83
 NAD83 Epoch _____
 Elev. _____
 Vert. Datum: NGVD29 NADV88
 Meas. Units: Metric Imperial

Corner - Left as found Found and tagged Established Reestablished Rebuilt

Identification and type of corner found: Evidence used to identify or procedure used to establish or reestablish the corner:

Monuments from 19 RS 23 were found and used as best evidence to reestablish the railroad spike that formerly monumented the above quarter corner location.


Many maps of record have accepted and used the railroad spike therefore simple proration was not considered for this reestablishment.

A description of the physical condition of the monument as found and as set or reset: Set a 3/4" Iron pin with plastic plug stamped L.S. 5443 above new concrete irrigation pipe line

SURVEYOR'S STATEMENT

This Corner Record was prepared by me or under my direction in conformance with the Land Surveyor's Act on March 18, 2014.

Signed [Signature] P.L.S. or R.C.E. No.: L.S.5443

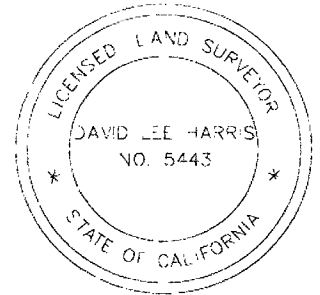


COUNTY SURVEYOR'S STATEMENT

This Corner Record was received May 14, 2014 and examined and filed June 2, 2014.

Signed [Signature] P.L.S. or R.C.E. No.: 26994

Title County Surveyor

County Surveyor's Comment _____

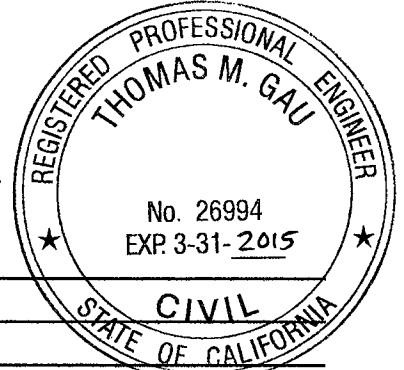

T.1S.,R.9E. M.D.M.



4 RS 185
(NO MONUMENTS FOUND)

FOUND AN OLD 60-D SPIKE AND SHINER BELOW 2 LAYERS OF PAVEMENT, ON PROJECTED LINE OF IRON PIPES FOUND I BELIEVE THIS TO HAVE BEEN SET ON 19 RS 23

HENRY ROAD

NOTE:
I DRILLED A HOLE IN NEW PAVEMENT AND SET A 3/4" PIN WITH CAP STAMPED L.S.5443 OVER TOP OF CONCRETE IRRIGATION PIPE FOR THE 1/4 CORNER TO REPLACE THE RAILROAD SPIKE SHOWN ON REFERENCE (A)

S.S.J.I.D. PIPE LINE

BASIS OF BEARINGS:

THE BEARING OF N 00°08'E FOR THE SECTION LINE BETWEEN SECTIONS 35 AND 36, TOWNSHIP 1 SOUTH, RANGE 9 EAST MOUNT DIABLO MERIDIAN, PER 19-RS-23, WAS USED AS THE BASIS OF BEARINGS FOR THIS PLAT

REFERENCES AND LEGEND:

REFERENCES ARE SAN JOAQUIN COUNTY

- (A) RECORD OF SURVEY BOOK 19, PAGE 23
SAN JOAQUIN COUNTY RECORDS
- SET 3/4" X 24" IRON PIN TAGGED
L.S. 5443 ABOVE CONC. IRRIGATION
PIPE LINE
- MONUMENT FD 1" IRON PIPE PER (A)
- FD. FOUND

S.S.J.I.D. SOUTH SAN JOAQUIN IRRIGATION DIST.

CORNER RECORD PLAT

THE RESETTING OF THE QUARTER CORNER BETWEEN SECTIONS 35 AND 36 OF TOWNSHIP 1 SOUTH, RANGE 9 EAST MOUNT DIABLO MERIDIAN LYING IN SAN JOAQUIN COUNTY, CALIFORNIA
MARCH, 2014

ASPEN SURVEY
COMPANY, INC.
1121 OAKDALE RD., STE. 6 MODESTO, CA 95355
PH: (209) 526-9724 FX: (209) 526-0472